


write/rain

OFFICE OF THE
DOUGLAS COUNTY SURVEYOR

G-083

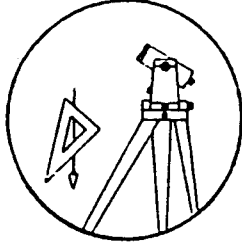

Station: GAUGING

T 23 S, R 4, Sec 5


Date Set: 2

Set By (Agency): USGS

Date Recovered: 2-11-97

Recovered By: RWS SJF

- Found
- Reset
- Referenced
- New
- Not Found
- Destroyed

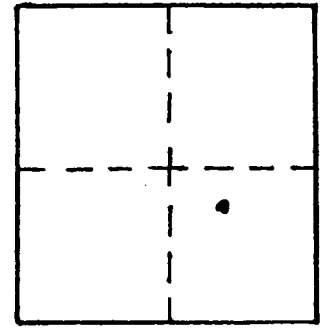

VERTICAL CONTROL

Elevation: 483.47 FT NGS Line # _____ USGS Line # _____ OSHD Line # _____

Precision: 3rd Agency: DCSO Proj. # 2007 Date: 1997

HORIZONTAL CONTROL CORPSCON6 NAVD88 487.12 FT. CS 66/54

South Zone O.C.S. 27: Y(Northing) _____ X(Easting) 714607

South Zone O.C.S. 83: Y(Northing) _____ X(Easting) 4207785

Precision: GIS SCALED Agency: DCSO Proj. # _____ Date: 2014

Approx. 1927 Geographic Position: Latitude 43°35'46" Longitude 123°11'33"

DESCRIPTION and TO REACH

3 3/4" DIA. USGS DISK STAMPED "GAUGING STATION" IS FOUND IN SOUTH WEST CURB OF CONCRETE BRIDGE.

FROM THE INTERSECTION OF CO. RD # 8 (SCOTT'S VALLEY RD) AND ELK HEAD RD (CO. RD # 7) IN T22S R4W S31 PROCEED SOUTHERLY ALONG CO. 7 1.8 MILES TO MONUMENT ON RIGHT IN SOUTH WEST CORNER OF CONCRETE BRIDGE.

Reference Marks:

