

3/9/81

h-004
H 335

24S 6W 29


OFFICE OF THE

DOUGLAS COUNTY SURVEYOR

NAD
83

666403.06
43°27'28"

4142368.87
123°26' 3"

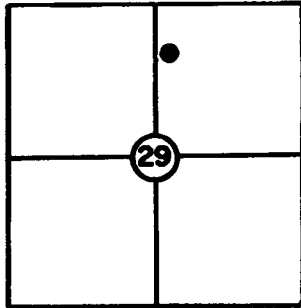

T 24 S, R 6W, Sec. 29

Station: H 335

Set By (Agency): USC & GS & SS

Date: _____

VERTICAL CONTROL

CORSON G NAVD88 823.08 FT

NGVD 29 819.49
Elevation: ~~819.490~~

NGS(USC&GS) Line # 326 USGS Line # _____

Order Of Precision 3rd Agency: USC & GS Proj. #: _____ Date: 1963

HORIZONTAL CONTROL

DCS 27

Oregon State Plane Coordinates: Y(Northing) 666,437.69 X(Easting) 1,221,409.49
(South Zone)


Order Of Precision 1/25,000 Agency: DCSO Proj. #: 2004-22 Date: 1981
(C.S. 61/22)

Approximate Geographic Position: Latitude= 43° 27' 29" Longitude= 123° 25' 59"

DESCRIPTION: From intersection of Green

Valley Rd. and Hwy. 138, go SW on dirt
Rd. 125 ft. to fenceline, go NW on Hwy.
side of fenceline 30 ft. to fenceline.
Approx. 5 ft. SE of fenceline.

SKETCH

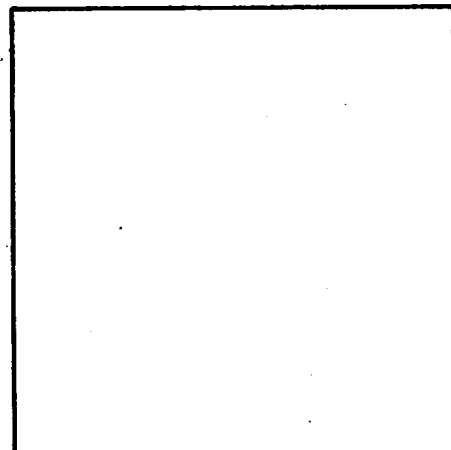

VICINITY: Approx. 9.3 mi. NW along State Hwy. 138
from Sutherlin.

NOTE: For Possible Further Information On This Station, Please Contact The Douglas County Surveyors Office, Rm. 205 Douglas County Justice Bldg., Roseburg, OR. 97470 Phone 672-3311 Ext. 272. Douglas County residents outside the Roseburg calling area dial toll free 1-800-452-0991.