

OFFICE OF THE
DOUGLAS COUNTY SURVEYOR


Station: H 675 T 28 S, R 6 W, Sec 15
 Set By (Agency): O.S.H.D.
 Date Set: 1978
 Recovered By RS,SJF
 Date Recovered June 21, 1984
 Recovered By _____
 Date Recovered _____
 Recovered By _____
 Date Recovered _____



h-010
H 675

285 6W 15

NAD 547071.45 4146125.41
83 43° 7'51" 123°24'16"

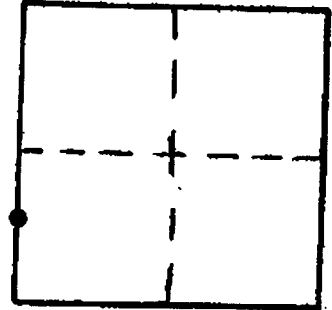

VERTICAL CONTROL NGVD 29 CORASCAN 6 NAVD 88 502.80 FT.

Elevation: 499.37 NGS Line # _____ USGS Line # _____ OSHD Line # 6
 Precision: 3rd. Agency: O.S.H.D. Proj. # _____ Date: 1978

HORIZONTAL CONTROL OCS 27

South Zone State Plane Coordinates: Y(Northing) 547,106.60 X(Easting) 1,225,167.10
 Precision: 1/25,000 Agency: DCSO Proj. # 2008-2013 Date: 1984
 Approximate Geographic Position: Latitude 43°07'52" Longitude 123°24'12"


DESCRIPTION and TO REACH

SKETCH

An O.S.H.D. disk stamped "H 675" set flush in the northwest corner of a concrete overflow structure.

TO REACH:

From the intersection of Lookingglass Road (Co. Rd.#107) and State Highway 99 in T28S,R6W,Sec.16, proceed easterly along State Highway 99 approximately 0.2 miles to monument on left. Monument lies in northwest corner of bridge over small creek (Winston Overflow Structure).

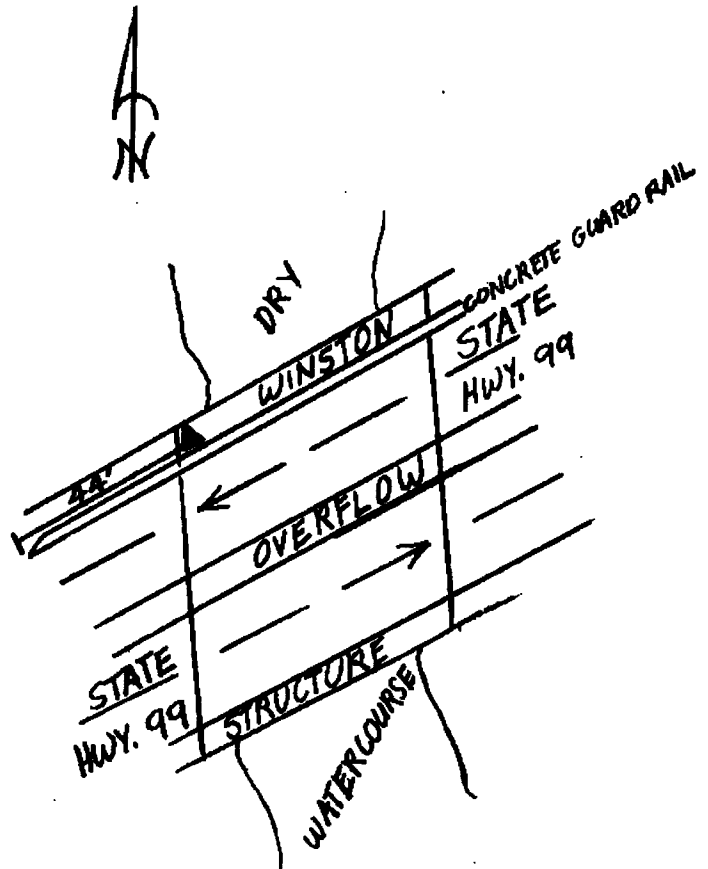

Reference Marks:

Note: For further information, contact the Douglas County Surveyor's Office, Room 205 Douglas County Justice Building, Roseburg, OR 97470. Phone 440-4278. Douglas County residents outside the Roseburg calling area, dial toll free 1-800-452-0991.