


11/19/81

OFFICE OF THE
DOUGLAS COUNTY SURVEYOR

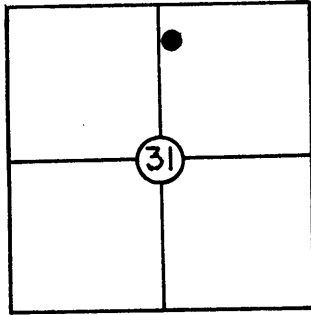

H-022

VERTICAL CONTROL

T 21 S, R 5 W, Sec. 31

Station: HARD

Set By (Agency): DCSO

Date: 1981

Elevation: _____ NGS(USC&GS) Line # _____ USGS Line # _____

Order
Of Precision _____ Agency: _____ Proj. #: _____ Date: _____

HORIZONTAL CONTROL

^{NAD 27}
Oregon State Plane Coordinates: Y(Northing) 755,426.32 X(Easting) 1,250,663.35
(South Zone)


(C.S. 61/20)

Order
Of Precision 1/25,000 Agency: DCSO Proj. #: 2004-21 Date: 1981

Approximate Geographic Position: Latitude= 43° 42' 17" Longitude= 123° 20' 03"

DESCRIPTION: Station is a DCSO brass cap
set in a 6"x42" conc. bell tile, stamped
"Hard 1981". Station is approx. 2" above
the ground. Witness post is approx. 4'
West of station. Station is approx. 5'
East of random fenceline running SSE and
NNW.

SKETCH

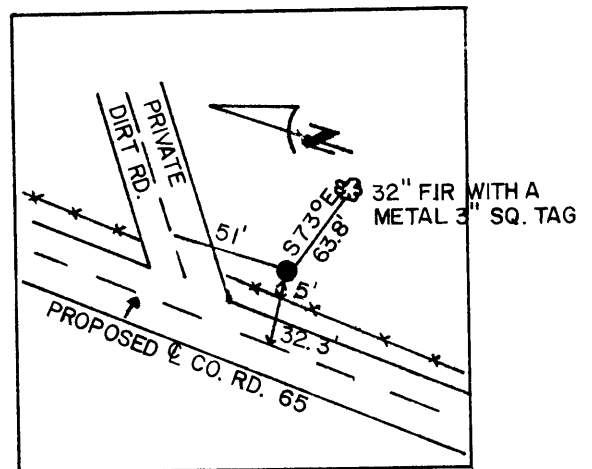

VICINITY: Northwest of Drain on Hardscrabble

Rd. approx. 1.1 mi. from the intersection
of Co. Rds. #65 & #37 (Hardscrabble & Smith River Rds.)

NOTE: For Possible Further Information On This Station, Please Contact The Douglas
County Surveyors Office, Rm. 205 Douglas County Justice Bldg., Roseburg, OR.
97470 Phone 672-3311 Ext. 272.. Douglas County residents outside the
Roseburg calling area dial toll free 1-800-452-0991.