


OFFICE OF THE

h-031
HENRY

26S 6W 5

DOUGLAS COUNTY SURVEYOR

NAD 622460.72 4138442.37
83 43°20'13" 123°26'36"

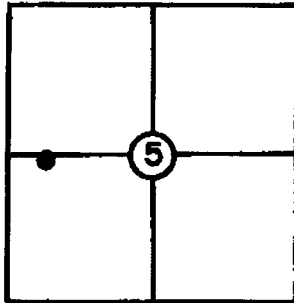

T 26 S, R 6W, Sec. 5

Station: Henry

Set By (Agency): DCS

Date: 1974

NGVD29

VERTICAL CONTROL CORPSCON6NAVD88 378.794 FT.

Elevation: 375.323 NGS(USC&GS) Line # _____ USGS Line # _____

Order
Of Precision 2nd Agency: DCSO Proj. #: 2007 Date: 1991

OCS 27

HORIZONTAL CONTROL


Oregon State Plane Coordinates: Y(Northing) 622,495.56 X(Easting) 1,217,483.60
(South Zone)

Order
Of Precision 1/25,000 Agency: DCSO Proj. #: 2006 Date: 1974

Approximate Geographic Position: Latitude= _____ Longitude= _____

DESCRIPTION: From Umpqua Post Office proceed
West 0.30 mi. to intersection, turn left across
bridge and proceed Southerly on Garden Valley
Rd. 2.30 mi. to sta. It is a DCSO brass cap
cemented in a 6" bell tile approx. 30' NE of
road centerline. Monument sets on a cut
bank approx. 10' higher than Rd. across road
from small turnout.

SKETCH

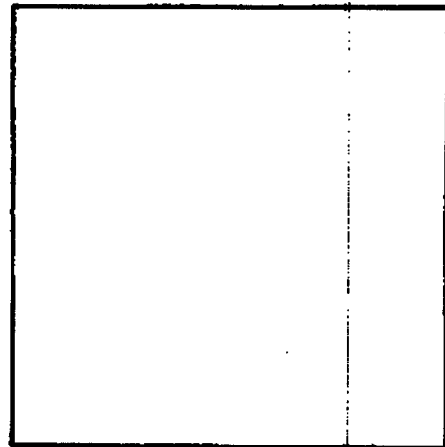

VICINITY: Garden Valley Rd. S. of Umpqua.

NOTE: For Possible Further Information On This Station, Please Contact The Douglas County Surveyors Office, Rm. 205 Douglas County Justice Bldg., Roseburg, OR. 97470 Phone 672-3311 Ext. 272.. Douglas County residents outside the Roseburg calling area dial toll free 1-800-452-0991.