



OFFICE OF THE
DOUGLAS COUNTY SURVEYOR

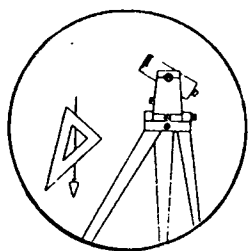

H-057

Station: HUDSON T 21 S, R 11 W , Sec 18
 Set By (Agency): DCPW
 Date Set: ?
 Recovered By RWS,SJF
 Date Recovered 12/13/88
 Recovered By _____
 Date Recovered _____
 Recovered By _____
 Date Recovered _____

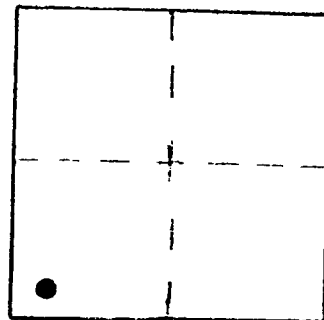

VERTICAL CONTROL NGVD 29 CORPCON 6 NAVD 88 23.26 FT
 Elevation: 19.68 NGS Line # _____ USGS Line # _____ OSHD Line # _____
 Precision: 3rd Agency: DCSO Proj. # 2006 Date: 1989

HORIZONTAL CONTROL
 South Zone State Plane Coordinates: Y(Northing) 776479 X(Easting) 3980311
 Precision: GIS SCALED Agency: DCSO Proj. # _____ Date: 2014
 Approximate Geographic Position: Latitude 43° 44' 32" Longitude 124° 03' 38"


DESCRIPTION and TO REACH

SKETCH

A DCPW disk stamped "HUDSON BM 1988" set in top of concrete railing on south side at east end of bridge over Hudson Slough.

TO REACH:

From the intersection of Southside Rd. (Co.Rd.#195) and Smith River Rd. (Co.Rd.#48) in T21S,R11W,Sec.19, proceed northeasterly along Smith River Rd. approximately 0.25 miles to east end of Hudson Slough Bridge and monument on right.

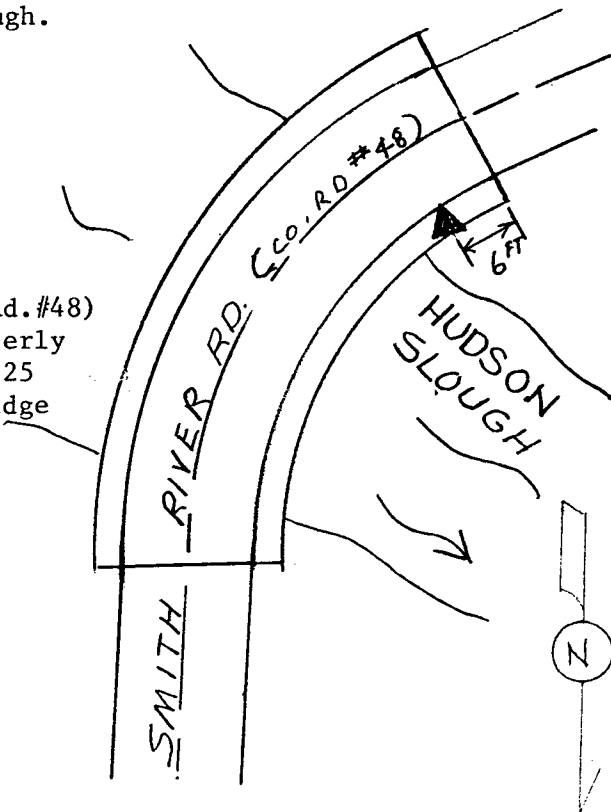

Reference Marks:

Note: For further information, contact the Douglas County Surveyor's Office, Room 205 Douglas County Justice Building, Roseburg, OR 97470. Phone 440-4278. Douglas County residents outside the Roseburg calling area, dial toll free 1-800-452-0991.