

Douglas County Geodetic Data Sheet

Station: HESTNES RESET
 Date Set: 1998 Set By (Agency): DCSO
 Last Date Recovered: 12/06/2000

Designation: H-068

T 26 R 06 WS 27

	▲

VERTICAL CONTROL

NGVD 29 Elevation: 409.41 Feet
 Precision: 3RD ORDER Agency: DCSO

CS File: 66027

Date: 1998

NAVD 88 Elevation: 412.88 FT.
 Precision: CORPSCON6 Agency:
 NAVD88

CS File:

Date:

HORIZONTAL CONTROL

OCS 27	Y(Northing):	X(Easting):	Lat	Long:
Precision:	Agency:		CS File:	Date:
OCS 83	Y(Northing): 602681	X(Easting): 4151238	Lat	Long:
Precision: 615 SCALED	Agency: DCSO		CS File:	Date: 2014
OCS 83/91	Y(Northing):	X(Easting):	Lat	Long:
Precision:	Agency:		CS File:	Date:
OCS 83/98	Y(Northing):	X(Easting):	Lat	Long:
Precision:	Agency:		CS File:	Date:

Scaled Lat 43° 17' 02"

Long: 123° 23' 30"


Description:

A DCSO BRASS CAP STAMPED; HESTNES RESET 1998; SET IN CONCRETE FOUNDATION OF OUTDOOR PRIVY.

Comments:

AT HESTNES LANDING OFF DEL RIO ROAD; CO. RD. 31

Notes:

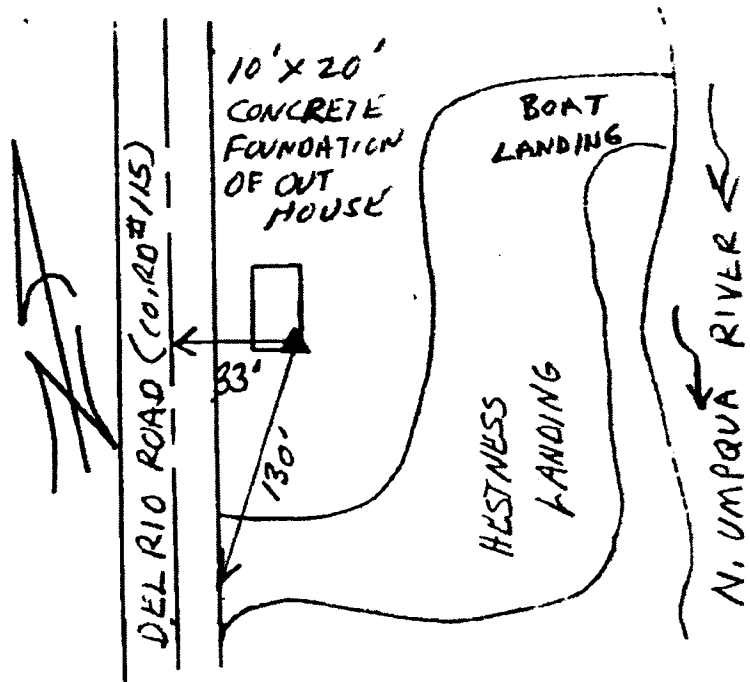

Note: For further information contact the Douglas County Surveyors Office, Room 105A Douglas County Courthouse, Roseburg, OR 97470. Phone 440-4272 or Fax (541)957-8150. Douglas County Residents outside Roseburg calling area, dial toll free 1-800-224-1619.