


OFFICE OF THE
DOUGLAS COUNTY SURVEYOR


Station: HEN-1
Date Set: 1998
Set By (Agency): DCSO
Date Recovered: 7-28-98
Recovered By: RWS SJF

T 22 S, R 7W, Sec. 19

H-070

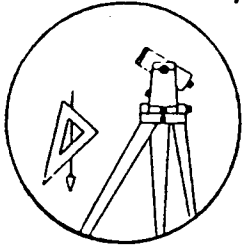

- Found New
 Reset Not Found
 Referenced Destroyed

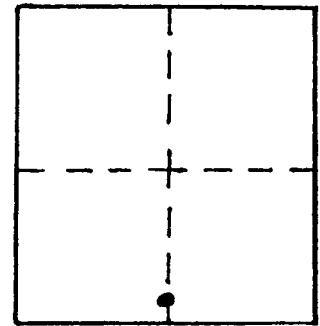

VERTICAL CONTROL

Elevation: 109.31 NGS Line # _____ USGS Line # _____ OSHD Line # _____
Precision: 3rd Agency: DCSO Proj. # 2007 Date: 1998

CORCON 6 NAVD 88 112.92 FT

HORIZONTAL CONTROL

South Zone O.C.S. 27: Y(Northing) _____ X(Easting) _____
South Zone O.C.S. 83: Y(Northing) 732987 X(Easting) 4106763
Precision: GIS SCALED Agency: DCSO Proj. # _____ Date: 2014
Approx. NAD 83 Geographic Position: Latitude 43° 38' 13" Longitude 123° 34' 35"

DESCRIPTION and TO REACH

A 2 3/4" DIA DCSO DRILL CAP STAMPED "HEN-1 1998"
IS SET IN AN 8" DIA BY 45" LONG CONCRETE FILLED
BELLTILE, PROTRUSING 7 IN ABOVE GROUND.

FROM THE INTERSECTION OF MEND CREEK ROAD
(CO. RD #11) AND HENDERER ROAD (CO. RD #118)
IN T22S R7W SEC 30, PROCEED NORTHWESTERLY
ALONG HENDERER ROAD 0.5 MILES TO MONUMENT
ON RIGHT.

OPEN FIELD



FIELD ACCESS ROAD

Reference Marks:

