


OFFICE OF THE
DOUGLAS COUNTY SURVEYOR

H-071

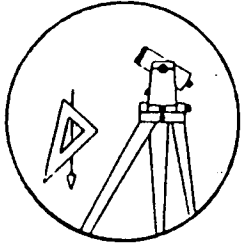

Station: HEN-2

T 22 S, R 8W, Sec 29


Date Set: 1998

Set By (Agency): DCSO

Date Recovered: 12/28/98

Recovered By: SQF

- | | |
|-------------------------------------|---|
| <input type="checkbox"/> Found | <input checked="" type="checkbox"/> New |
| <input type="checkbox"/> Reset | <input type="checkbox"/> Not Found |
| <input type="checkbox"/> Referenced | <input type="checkbox"/> Destroyed |

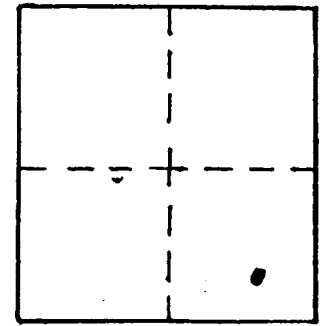

VERTICAL CONTROL

Elevation: 107.06 NGS Line # _____ USGS Line # _____ OSHD Line # _____

Precision: 3RD Agency: DCSO Proj. # 2007 Date: 1998

HORIZONTAL CONTROL CORPSCON6 NAVD88 110.65 FT CS66/52

South Zone O.C.S. 27: Y(Northing) _____ X(Easting) _____

South Zone O.C.S. 83: Y(Northing) 733529 X(Easting) 4103986

Precision: GIS SCALED Agency: DCSO Proj. # _____ Date: 2014

Approx. NAD 83 Geographic Position: Latitude 43° 38' 18" Longitude 123° 35' 16"

DESCRIPTION and TO REACH

A 3 INCH DIAMETER DCSO DISK STAMPED "HEN-2 1998" SET IN TOP OF AN 8x42 INCH CONCRETE FILLED CONCRETE BELL TILE FIRMLY SET AND PROTRUDING APPROXIMATELY 3 INCHES ABOVE GROUND

FROM THE INTERSECTION OF MEHL CREEK ROAD (Co. RD #11) AND HENDERER ROAD (Co. Rd. #118) IN T22S, R7W, SEC 30 PROCEED NORTHERLY AND WESTERLY ALONG HENDERER ROAD (Co. RD. #118) APPROXIMATELY 1.05 MILES TO MONUMENT ON THE RIGHT.

Reference Marks:

