



OFFICE OF THE
DOUGLAS COUNTY SURVEYOR

H-072

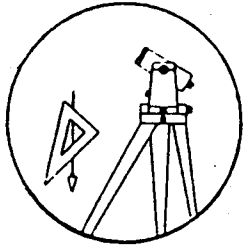

Station: HEN-3
Date Set: 1998
Set By (Agency): DCSO
Date Recovered: 8-5-98
Recovered By: RWS SUF

T 22 S, R 8W, Sec 23

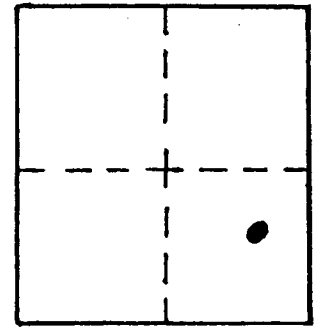

- Found
- New
- Reset
- Not Found
- Referenced
- Destroyed

VERTICAL CONTROL

Elevation: 201.11 NGS Line # _____ USGS Line # _____ OSHD Line # _____

Precision: 3rd Agency: DCSO Proj. # 2007 Date: 1998

HORIZONTAL CONTROL CORPSCON6 NAVD88 204.69 FT CS 66/52

South Zone O.C.S. 27: Y(Northing) _____ X(Easting) _____

South Zone O.C.S. 83: Y(Northing) 734389 X(Easting) 4098455

Precision: GIS SCALED Agency: DCSO Proj. # _____ Date: 2014

Approx. NAD 83 Geographic Position: Latitude 43° 38' 24" Longitude 123° 36' 27"

DESCRIPTION and TO REACH

2 3/4" DIA DCSO PRILL CAP IS SET IN AN
8" DIA. BY 45 IN LONG CONCRETE FILLED
BELL TILE, STAMPED "HEN-3 1998" PROTRUDING
16" ABOVE GROUND.

FROM THE INTERSECTION OF ALBIL CREEK ROAD
(CO. RD # 115) AND HENDERER ROAD (CO. RD # 118)
IN T 22 S R 7 W SEC 30. PROCEED NORTHWESTERLY
ALONG HENDERER ROAD 2.15 MILES TO MONUMENT
ON LEFT.

Reference Marks:

