


OFFICE OF THE
DOUGLAS COUNTY SURVEYOR

H#073

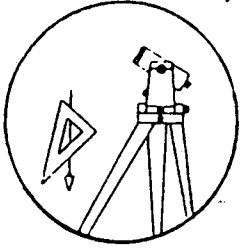

Station: HEN-4

T 22 S, R 8W, Sec 23


Date Set: JULY, 1998

Set By (Agency): DCSO

Date Recovered: 8/5/98

Recovered By: RWS, SJF

- Found
- New
- Reset
- Not Found
- Referenced
- Destroyed

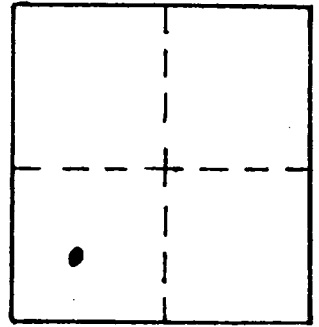

VERTICAL CONTROL

Elevation: 160.82 NGS Line # _____ USGS Line # _____ OSHD Line # _____

Precision: 3rd Agency: DCSO Proj. # 2007 Date: 1998

HORIZONTAL CONTROL CORPSCON6 NAVD88 164.39 FT CS 66152

South Zone O.C.S. 27: Y(Northing) _____ X(Easting) _____

South Zone O.C.S. 83: Y(Northing) 734652 X(Easting) 4095847

Precision: GIS SCALED Agency: DCSO Proj. # _____ Date: 2014

Approx. NAD 83 Geographic Position: Latitude 43 30 25 Longitude 123 37 04

DESCRIPTION and TO REACH

A DCSO DISK STAMPED "HEN-4 1998" SET FLUSH IN TOP OF CONCRETE FILLED 8X4S INCH CONCRETE BELL-TILE FIRMLY SET AND PROTRUDING APPROXIMATELY 6 INCHES ABOVE GROUND.

FROM THE INTERSECTION OF MEHL CREEK RD. (CO. RD. # 11) AND HENDERER ROAD (CO. RD. # 118) IN T22S, R7W, SEC 30 PROCEED NORTHWESTERLY ALONG HENDERER ROAD APPROXIMATELY 2.70 MILES TO MONUMENT ON LEFT.

Reference Marks:

