
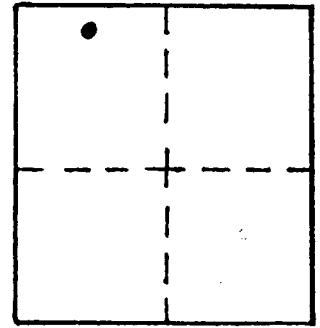


OFFICE OF THE
DOUGLAS COUNTY SURVEYOR

Station: HEN-6
Date Set: JULY, 1998
Set By (Agency): DCSO
Date Recovered: 7/30/98
Recovered By: RWS SJF

T 22 S, R 8W, Sec 28

H-075

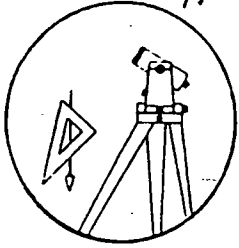

- Found
- New
- Reset
- Not Found
- Referenced
- Destroyed

VERTICAL CONTROL

1' 20" Elevation: 120.55 NGS Line # _____ USGS Line # _____ OSHD Line # _____

Precision: 3rd Agency: DCSO Proj. # 2007 Date: 1998

HORIZONTAL CONTROL CORPSCON6 NAVD88 124.12 FT CS 66152

South Zone O.C.S. 27: Y(Northing) _____ X(Easting) _____

South Zone O.C.S. 83: Y(Northing) 733128 X(Easting) 4084880

Precision: GIS SCALED Agency: DCSO Proj. # _____ Date: 2014

Approx. NAD 83 Geographic Position: Latitude 43° 38' 06" Longitude 123° 39' 32"

DESCRIPTION and TO REACH

A DCSO DISK STAMPED "HEN-6 1998" SET FLUSH IN TOP OF CONCRETE FILLED 9 INCH O.D. PLASTIC PIPE FIRMLY SET AND PROTRUDING 6 INCHES ABOVE GROUND.

FROM THE INTERSECTION OF MEHL CREEK ROAD (CORP. # 67) AND HENDERER ROAD (CORP. # 118) IN T22S, R7W, SEC. 30 PROCEED NORTHWESTERLY ALONG HENDERER ROAD APPROXIMATELY 4.45 MILES TO MONUMENT ON LEFT.

Reference Marks:

