

OFFICE OF THE
DOUGLAS COUNTY SURVEYOR

Station: HEN-8

T 22 S, R 86W, Sec 20



Date Set: JULY 1998

Set By (Agency): DCSO

Date Recovered: JULY 28, 1998

Recovered By: RWS, SJF

- Found
- New
- Reset
- Not Found
- Referenced
- Destroyed

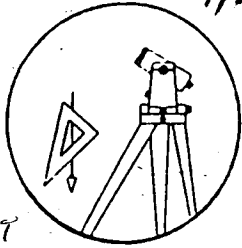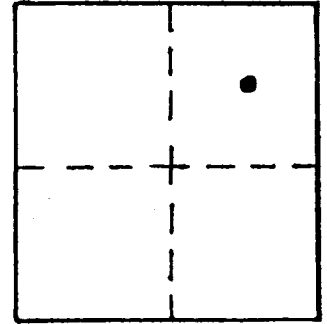

2' W
2' W
7200 475'

VERTICAL CONTROL

Elevation: 97.34 NGS Line # _____ USGS Line # _____ OSHD Line # _____

Precision: 3rd Agency: DCSO Proj. # 2007 Date: 1998

HORIZONTAL CONTROL CORPS CONG NAVD88 100.90 FT CS66/52

South Zone O.C.S. 27: Y(Northing) _____ X(Easting) _____

South Zone O.C.S. 83: Y(Northing) 737275 X(Easting) 4082092

Precision: GIS SCALED Agency: DCSO Proj. # _____ Date: 2014

Approx. NAD 83 Geographic Position: Latitude 43° 38' 46" Longitude 123° 40' 12"

DESCRIPTION and TO REACH

A DCSO RISK STAMPED "HEN-8 1998" SET FLUSH IN TOP OF CONCRETE FILLED 8x4S INCH CONCRETE BELLTILE WHICH IS FIRMLY SET AND PROTRUDES APPROXIMATELY 6 INCHES ABOVE GROUND.

FROM THE INTERSECTION OF MEHL CREEK ROAD (Co Rd. #11) AND HENDERER ROAD (Co Rd. #11B) IN T22S, R71W, SEC 30 PROCEED NORTH-WESTERLY ALONG HENDERER RD. APPROXIMATELY 6.54 MILES TO HENDERER ROAD (Co Rd # 67A) AND BRIDGE ROAD (CR 2-8-22.1) PROCEED WESTERLY ALONG HENDERER ROAD 1.3 MILES TO MONUMENT ON LEFT.

Reference Marks:

