


Date Set: 3-1-00

Set By (Agency): DCSO


Date Recovered: 3-1-00

Recovered By: RWS SIF

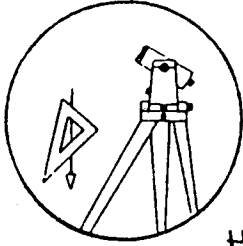

H-079

- Found
- New
- Reset
- Not Found
- Referenced
- Destroyed

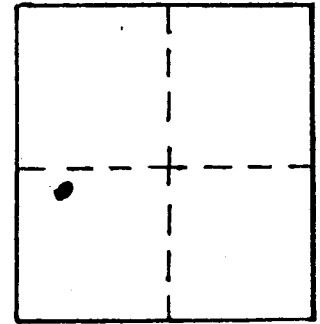

VERTICAL CONTROL

Elevation: 348.52 NGS Line # \_\_\_\_\_ USGS Line # \_\_\_\_\_ OSHD Line # \_\_\_\_\_

Precision: 3rd Agency: DCSO Proj. # 2007 Date: 2000

HORIZONTAL CONTROL CORPSCON6 NAVD88 352.02 FF:566/53

South Zone O.C.S. 27: Y(Northing) \_\_\_\_\_ X(Easting) \_\_\_\_\_

South Zone O.C.S. 83: Y(Northing) 633684 X(Easting) 4123260

Precision: GIS SCALED Agency: DCSO Proj. # \_\_\_\_\_ Date: 2014

Approx. NAD <sup>83</sup> Geographic Position: Latitude 43° 21' 58" Longitude 123° 30' 02"

DESCRIPTION and TO REACH

From THE INTERSECTION OF MELGUA RD  
(CO. RD # 13A) AND HUBBARD CRK RD (CO. RD #6)  
IN T25S R7W SEC 26 PROCEED WESTERLY  
ALONG HUBBARD CRK RD 0.7 MILES TO  
MONUMENT ON RIGHT AT NORTH EAST CORNER  
OF CONCRETE BRIDGE OVER SMALL CREEK

FOUND UNMARKED BRASSCAP IN NORTHEAST WING WALL.  
WE STAMP "DCSO HUBBA-1 2000"

Reference Marks:

