


OFFICE OF THE
DOUGLAS COUNTY SURVEYOR

3'x2'x3'

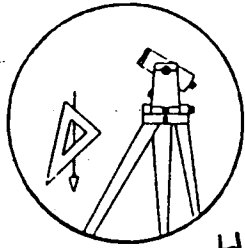

H-080

Station: HUBBA-2

T 25 S, R 7W, Sec 27


Date Set: 3-1-00

Set By (Agency): DCSO

Date Recovered: 3-1-00

Recovered By: RWS SJF

- Found
- New
- Reset
- Not Found
- Referenced
- Destroyed

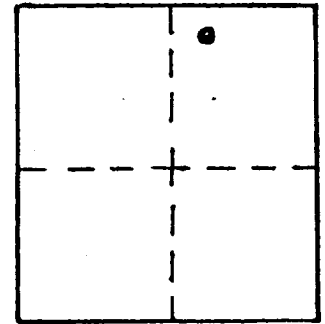

VERTICAL CONTROL

Elevation: 354.52 NGS Line # _____ USGS Line # _____ OSHD Line # _____

Precision: 3rd Agency: DCSO Proj. # 2007 Date: 2000

HORIZONTAL CONTROL CORPSCONV NAVD88 358.03 FT. CS66/53

South Zone O.C.S. 27: Y(Northing) _____ X(Easting) _____

South Zone O.C.S. 83: Y(Northing) 636495 X(Easting) 4120026

Precision: GIS SCALED Agency: DCSO Proj. # _____ Date: 2014

Approx. NAD 83 Geographic Position: Latitude 43 22 23 Longitude 123 30 44

DESCRIPTION and TO REACH

FROM THE INTERSECTION OF MELQUA RD (CO RD #13A)
AND HUBBARD CRK RD (CO RD #6) IN T25S R7W SEC26
PROCEED 1/4 MILE WESTERLY ALONG HUBBARD CRK RD
1/5 MILES TO MONUMENT ON LEFT.

DCSO DRILL CAP SET IN TOP OF A 3'X2'X3'
HIGH ROCK OUT CROP IN CUT BANK. BRASS CAP
STAMPED "HUBBA-2 2000"

Reference Marks:

