

OFFICE OF THE
DOUGLAS COUNTY SURVEYOR

Station: HUBBA -3


T 25 S, R 7W, Sec 21

Date Set: 3-1-00

Set By (Agency): DCSO


Date Recovered: 3-1-00

Recovered By: RWS (SJF)

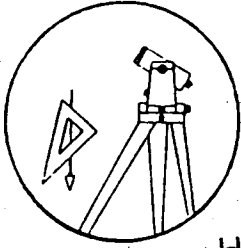

H-081

- Found
- New
- Reset
- Not Found
- Referenced
- Destroyed

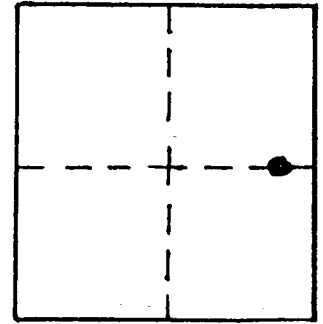

VERTICAL CONTROL

Elevation: 363.92 NGS Line # _____ USGS Line # _____ OSHD Line # _____

Precision: 3rd Agency: DCSO Proj. # 2007 Date: 2000

HORIZONTAL CONTROL CORPSCON6 NAVD88 367.43 FT. CS66153

South Zone O.C.S. 27: Y(Northing) _____ X(Easting) _____

South Zone O.C.S. 83: Y(Northing) 639438 X(Easting) 4116073

Precision: GIS SCALED Agency: DCSO Proj. # _____ Date: 2014

Approx. NAD ⁸³ Geographic Position: Latitude 43 22 53 Longitude 123 31 41

DESCRIPTION and TO REACH

From THE INTERSECTION OF MELQUA RD (CORD #13A)
AND HUBBARD CRK RD (CORD #6) IN T25S R7W
SEC 26 PROCEED WESTERLY ALONG
HUBBARD CRK RD 255 METERS TO MONUMENT ON
LEFT IN ROCK OUT CROP.

DCSO DRILL CAP SET IN TOP OF A 6' X 3' X
4' HIGH ROCK OUT CROP IN ROAD CUT
BANK. BRASS CAP STAMPED "HUBBA-3 2000"

Reference Marks:

