

OFFICE OF THE
DOUGLAS COUNTY SURVEYOR

Station: HUBBA-5


T 25 S, R 57N, Sec 20

Date Set: 3-1-00

Set By (Agency): DCSO


Date Recovered: 3-1-00

Recovered By: RNS SJF

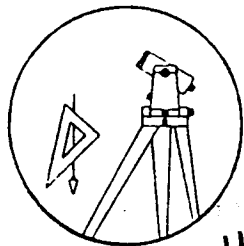

H-083

- Found
- New
- Reset
- Not Found
- Referenced
- Destroyed

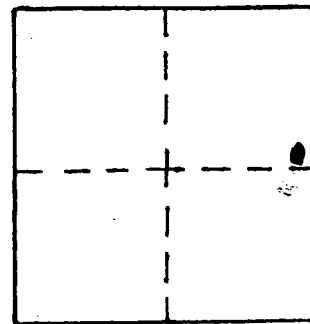

VERTICAL CONTROL

Elevation: 366.86 NGS Line # _____ USGS Line # _____ OSHD Line # _____

Precision: 3rd Agency: DCSO Proj. # CS 46/53 2007 Date: 2000

HORIZONTAL CONTROL CORPSCON6 NAVD88 370.36 FT.

South Zone O.C.S. 27: Y(Northing) _____ X(Easting) _____

South Zone O.C.S. 83: Y(Northing) 640039 X(Easting) 411634

Precision: GIS SCALED Agency: DCSO Proj. # _____ Date: 2014

Approx. NAD ⁸³ Geographic Position: Latitude 43° 22' 56" Longitude 123° 32' 43"

DESCRIPTION and TO REACH

FROM THE INTERSECTION OF MELQUA RD (CO. RD #13A)
AND HUBBARD CRK RD (CO. RD #6) IN TRSS R7W SEC. 26
PROCEED WESTERLY ALONG HUBBARD CRK RD
3.8 MILES TO MONUMENT ON RIGHT. IN A ROCK OUTCROP

DCSO DRILL CAP SET NEAR TOP OF A 2' X 5"
EXPOSED ROCK CUT BANK IN A SMALL LEDGE.
STAMPED "HUBBA-5 2000".

Reference Marks:

