

OFFICE OF THE
DOUGLAS COUNTY SURVEYOR

Station: HUBBA-7


T 25 S, R 7W, Sec 29

Date Set: 3-1-2000

Set By (Agency): DCSO


Date Recovered: 3-1-2000

Recovered By: RWS SJF

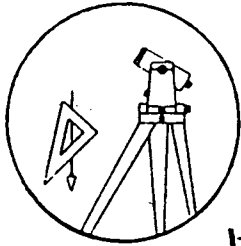

H-085

- Found
- New
- Reset
- Not Found
- Referenced
- Destroyed

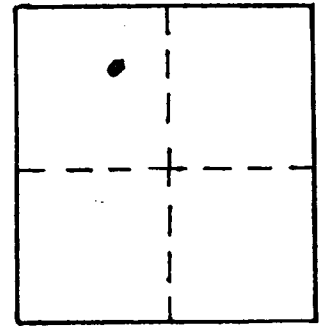

VERTICAL CONTROL

Elevation: 383.10 NGS Line # _____ USGS Line # _____ OSHD Line # _____

Precision: 3rd Agency: DCSO Proj. # 2007 Date: 2000

HORIZONTAL CONTROL CORPSCON6 NAVD88 386.60 FT. CS66/53

South Zone O.C.S. 27: Y(Northing) _____ X(Easting) _____

South Zone O.C.S. 83: Y(Northing) 636449 X(Easting) 4108249

Precision: GIS SCALED Agency: DCSO Proj. # _____ Date: 2014

Approx. NAD 83 Geographic Position: Latitude 43° 22' 21" Longitude 123° 33' 26"

DESCRIPTION and TO REACH

FROM THE INTERSECTION OF MELQUA RD (CO. RD #13A)
AND HUBBARD CRK RD (CO. RD #6) IN T25S R7W SEC 26
PROCEED WESTERLY ALONG HUBBARD CRK RD
4.8 MILES TO BLM RD # 25-7-29.1 AND MONUMENT
ON LEFT IN CONCRETE BRIDGE OVER HUBBARD CRK

DCSO DRILL CAP STAMPED "HUBBA-7 2000" SET IN NORTH
WEST CORNER OF CONCRETE BRIDGE OVER HUBBARD
CRK ON BLM RD # 25-7-29.1

Reference Marks:

