

Station: HUBBA-10


T 25 S, R 7W, Sec 31

Date Set: 3-1-00

Set By (Agency): DCSO


Date Recovered: 3-1-00

Recovered By: RWS SJF

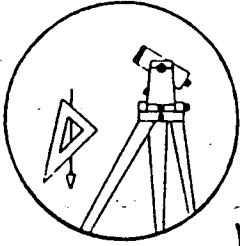

H-088

- Found
- New
- Reset
- Not Found
- Referenced
- Destroyed

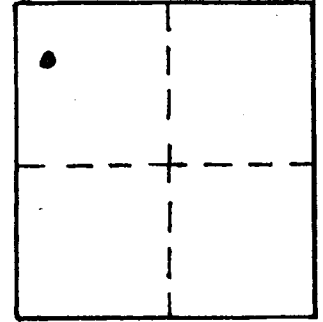

VERTICAL CONTROL

Elevation: 507.25 NGS Line # _____ USGS Line # _____ OSHD Line # _____

Precision: 3rd Agency: DCSO Proj. # 2007 Date: 2000

HORIZONTAL CONTROL CORPSCON6 NAVD88 510.76 FT. CS 66/53

South Zone O.C.S. 27: Y(Northing) _____ X(Easting) _____

South Zone O.C.S. 83: Y(Northing) 631281 X(Easting) 4101212

Precision: GIS SCALED Agency: DCSO Proj. # _____ Date: 2014

Approx. NAD ⁸³ Geographic Position: Latitude 43° 21' 27" Longitude 123° 34' 58"

DESCRIPTION and TO REACH

FROM THE INTERSECTION OF MELONA RD (CO. RD #13A)
AND HUBBARA CRK RD (CO. RD #6) IN T 25S R 7W SEC 26
PROCEED WESTERLY ALONG HUBBARA CRK RD 6.6 MILES
TO MONUMENT ON LEFT

DCSO DRILL CAP STAMPED "HUBBA-10 2000" SET IN A
6' X 3 1/2' X 7' HIGH ROCK OUTCROP

Reference Marks:

WIT POST
T SIGN
N 45° W
7'

