

OFFICE OF THE
DOUGLAS COUNTY SURVEYOR

Station: HUBBA-11

T 25 S, R 8W, Sec 36



Date Set: 3-1-00

Set By (Agency): DCSO

Date Recovered: 3-1-00

Recovered By: RWS SJF

- Found New
 Reset Not Found
 Referenced Destroyed

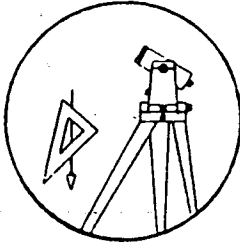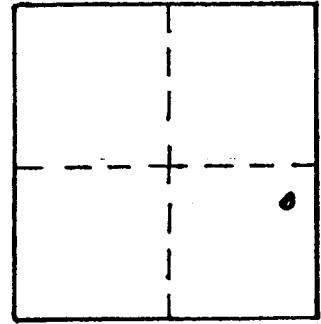

H-089

VERTICAL CONTROL

Elevation: 524.33 NGS Line # _____ USGS Line # _____ OSHD Line # _____

Precision: 3rd Agency: DCSO Proj. # 2007 Date: 2000

HORIZONTAL CONTROL CORPSCON6 NAVD88 527.84 FT. CS 66/53

South Zone O.C.S. 27: Y(Northing) _____ X(Easting) _____

South Zone O.C.S. 83: Y(Northing) 628835 X(Easting) 4100651

Precision: GIS SCALED Agency: DCSO Proj. # _____ Date: 2014

Approx. NAD ⁸³/₂₇ Geographic Position: Latitude 43° 21' 02" Longitude 127° 35' 04"

DESCRIPTION and TO REACH

FROM THE INTERSECTION OF MELQUA RD (CO. RD #13A)
AND HUBBARD CRK RD (CO. RD #6) IN T25S R7W SEC 26
PROCEED WESTERLY ALONG HUBBARD CRK RD 7.1 MILES
TO MONUMENT ON LEFT.

DCSO DRILL CAP STAMPED "HUBBA-11 2000" SET IN
A 3'x2' ROCK THAT IS FLUSH WITH GROUND.

Reference Marks:

