

OFFICE OF THE
DOUGLAS COUNTY SURVEYOR

Station: HUBBA-12


T 26 S, R 8W, Sec 1

Date Set: 3-1-00

Set By (Agency): DCSO


Date Recovered: 3-1-00

Recovered By: RWS SJF

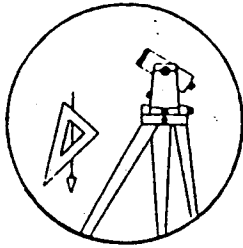

H-090

- Found
- New
- Reset
- Not Found
- Referenced
- Destroyed

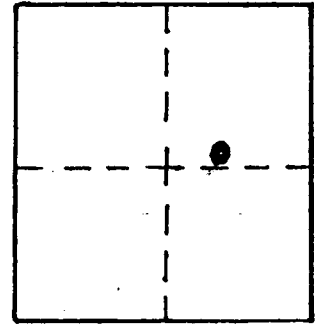

VERTICAL CONTROL

Elevation: 543.48 NGS Line # _____ USGS Line # _____ OSHD Line # _____

Precision: 3rd Agency: DCSO Proj. # 2007 Date: 2000

HORIZONTAL CONTROL CORPSCONG NAVD88 547.01 FT. CS 66/53

South Zone O.C.S. 27: Y(Northing) _____ X(Easting) _____

South Zone O.C.S. 83: Y(Northing) 623721 X(Easting) 4098959

Precision: GIS SCALED Agency: DCSO Proj. # _____ Date: 2014

Approx. NAD ⁸³/₂₇ Geographic Position: Latitude 43° 20' 20" Longitude 123° 35' 23"

DESCRIPTION and TO REACH

FROM THE INTERSECTION OF MELQUA RD (CO. RD #13A)
AND HUBBARD CRK RD (CO. RD #6) IN T27S R5W SEC 26
PROCEED WESTERLY ALONG HUBBARD CRK RD 8.0 MILES
TO CONCRETE BRIDGE OVER A SMALL CREEK AND
MONUMENT AT SOUTHEAST CORNER OF BRIDGE

DCSO DRILL CAP STAMPED "HUBBA-12 2000" SET
IN SOUTH EAST WING WALL OF CONCRETE BRIDGE.

Reference Marks:

