

H-091

OFFICE OF THE
DOUGLAS COUNTY SURVEYOR

Station: HOCEVAR


T 27 S, R 3W, Sec 12

Date Set: 1999

Set By (Agency): DCSO


Date Recovered: JULY 1, 1999

Recovered By: RWS, SJF

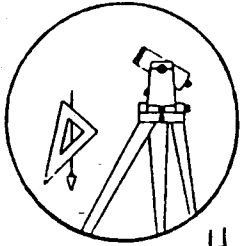

H-091

- Found
- New
- Reset
- Not Found
- Referenced
- Destroyed

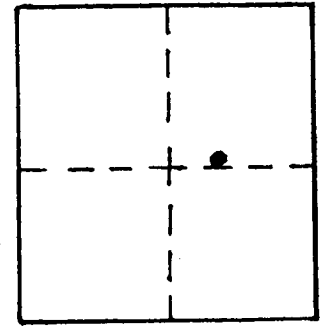

VERTICAL CONTROL

Elevation: 938.56 NGS Line # _____ USGS Line # _____ OSHD Line # _____

Precision: 3rd Agency: DCSO Proj. # 2007 Date: 1999

HORIZONTAL CONTROL CORPSCON6 942.18 FT. CS66156

South Zone O.C.S. 27: Y(Northing) NAVD88 X(Easting) _____

South Zone O.C.S. 83: Y(Northing) 581580 X(Easting) 4255814

Precision: GIS SCALED Agency: DCSO Proj. # _____ Date: 2014

Approx. OC527 ~~NAVD83~~ Geographic Position: Latitude 43° 14' 07" Longitude 122° 59' 47"

DESCRIPTION and TO REACH

A 2 3/8 INCH DIAMETER DCSO DRILL CAP STAMPED "HOCEVAR 1999"
SET FLUSH IN TOP OF CONCRETE CURB OF CONCRETE APPROACH TO
PRIVATE WOODEN BRIDGE FOR GOODREAU LANE CROSSING OF
LITTLE RIVER.

GO TO THE INTERSECTION OF LITTLE RIVER ROAD (Co. Rn. #17C)
AND GOODREAU LANE. IN T27S, R36, SEC12 TO MONUMENT AT
NORTHEAST CORNER OF BRIDGE APPROACH.

Reference Marks:

