

OFFICE OF THE
DOUGLAS COUNTY SURVEYOR

Station: HOLLY


T 27 S, R 6W, Sec 11

Date Set: 2000


Set By (Agency): DCSO

Date Recovered: 5/24/00

Recovered By: DCSO

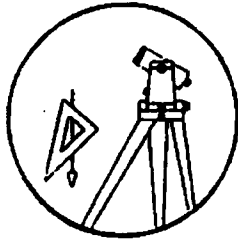

- Found
- New
- Reset
- Not Found
- Referenced
- Destroyed

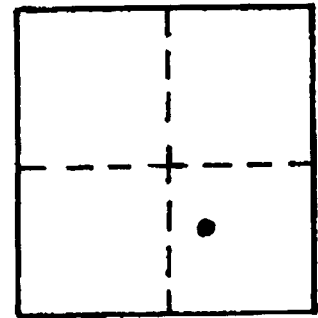

H-093

VERTICAL CONTROL NGVD 29 CORPSCON 6 NAVD 88 452.54 FT

Elevation: 449.07 NGS Line # _____ USGS Line # _____ OSHD Line # _____

Precision: 3rd Agency: DCSO Proj # 66/38 Date: 2000

HORIZONTAL CONTROL

South Zone O.C.S. 27: Y(Northing) _____ X(Easting) _____

South Zone O.C.S. 83: Y(Northing) _____ X(Easting) _____

Precision: _____ Agency: _____ Proj. # _____ Date: _____

Approx. NAD 83 Geographic Position: Latitude 43° 13' 52.8" Longitude 123° 22' 22.6"

27 43° 13' 53.4" 123° 22' 18.3"

DESCRIPTION and TO REACH

A DCSO DRILL CAP STAMPED "HOLLY 2000" SET FLUSH IN TOP, AND NEAR CENTER, OF CONCRETE HEADWALL AT SOUTHERLY END OF LARGE CULVERT ON NEWTON CREEK.

GO TO INTERSECTION OF NORTH GARDEN VALLEY BLVD AND STEWART PARKWAY IN T27S, R6W, SEC 11. MONUMENT LIES IN SOUTHEASTERLY QUADRANT OF INTERSECTION.

Reference Marks:

