

write/rain

OFFICE OF THE
DOUGLAS COUNTY SURVEYOR

Station: HEINRICH


T 30 S, R 5, Sec 7

Date Set: 2001

Set By (Agency): DCSO


Date Recovered: 3-20-01

Recovered By: RWS SJF

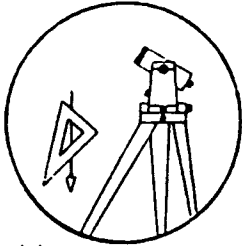

H-094

- Found
- New
- Reset
- Not Found
- Referenced
- Destroyed

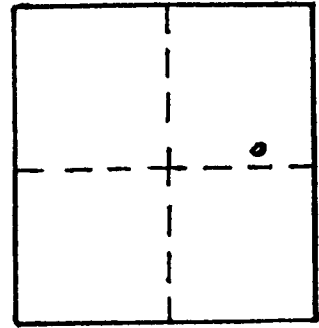

VERTICAL CONTROL CORPSCON6 NAVDBB 702.45 FT.

Elevation: 699.04 NGS Line # _____ USGS Line # _____ OSHD Line # _____

Precision: 3rd Agency: DCSO Proj. # 2007 Date: 2001

HORIZONTAL CONTROL

South Zone O.C.S. 27: Y(Northing) _____ X(Easting) _____

South Zone O.C.S. 83: Y(Northing) 490479 X(Easting) 4164917

Precision: GISSCALED Agency: DCSO Proj. # _____ Date: 2014

Approx. NAD 83 Geographic Position: Latitude 42° 58' 39" Longitude 123° 19' 33"

DESCRIPTION and TO REACH

DCSO DRILL CAP STAMPER "HEINRICH 2001"
SET IN TOP OF CONCRETE CURB.

GO TO THE INTERSECTION OF OLDSTATE HWY 99
(CO. RD 386) AND HENRY ST (CO. RD 225) IN TR/CITY.
MONUMENT IS EAST OF INTERSECTION.

Reference Marks:

