



I-001

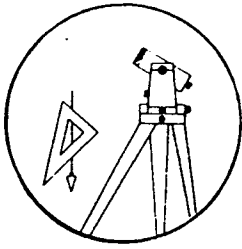

Station: I-10 T 25 S, R 5 W, Sec 17  
Set By (Agency): USC&GS  
Date Set: 1920  
Recovered By RWS, TF  
Date Recovered 4/13/87  
Recovered By \_\_\_\_\_  
Date Recovered \_\_\_\_\_  
Recovered By \_\_\_\_\_  
Date Recovered \_\_\_\_\_

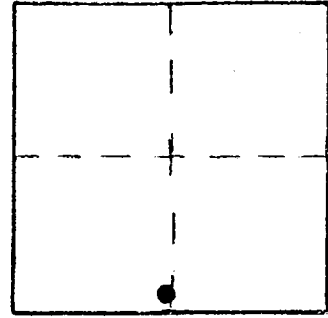

VERTICAL CONTROL

Elevation: 518.352 NGS Line # 6 USGS Line # \_\_\_\_\_ OSHD Line # \_\_\_\_\_  
Precision: 1st Agency: USC&GS Proj. # \_\_\_\_\_ Date: 1957

HORIZONTAL CONTROL CORPSCON6 NAVD88 521.87 FT.

South Zone State Plane Coordinates: Y(Northing) 640491 X(Easting) 4172676  
Precision: GIS SCALED Agency: DCSO Proj. # \_\_\_\_\_ Date: 2014  
Approximate Geographic Position: Latitude \_\_\_\_\_ Longitude \_\_\_\_\_


DESCRIPTION and TO REACH

A USG&GS disk stamped "ELEV 517.765  
1920 I-10" set in a concrete curb.

TO REACH:

Go to the crossing of Central Ave.  
(State Hwy. #138) and S.P.R.R. tracks in  
T25S,R5W,Sec.17, (Sutherlin). Monument  
is easterly approx. 75 ft. from crossing  
in northerly street curb.

SKETCH

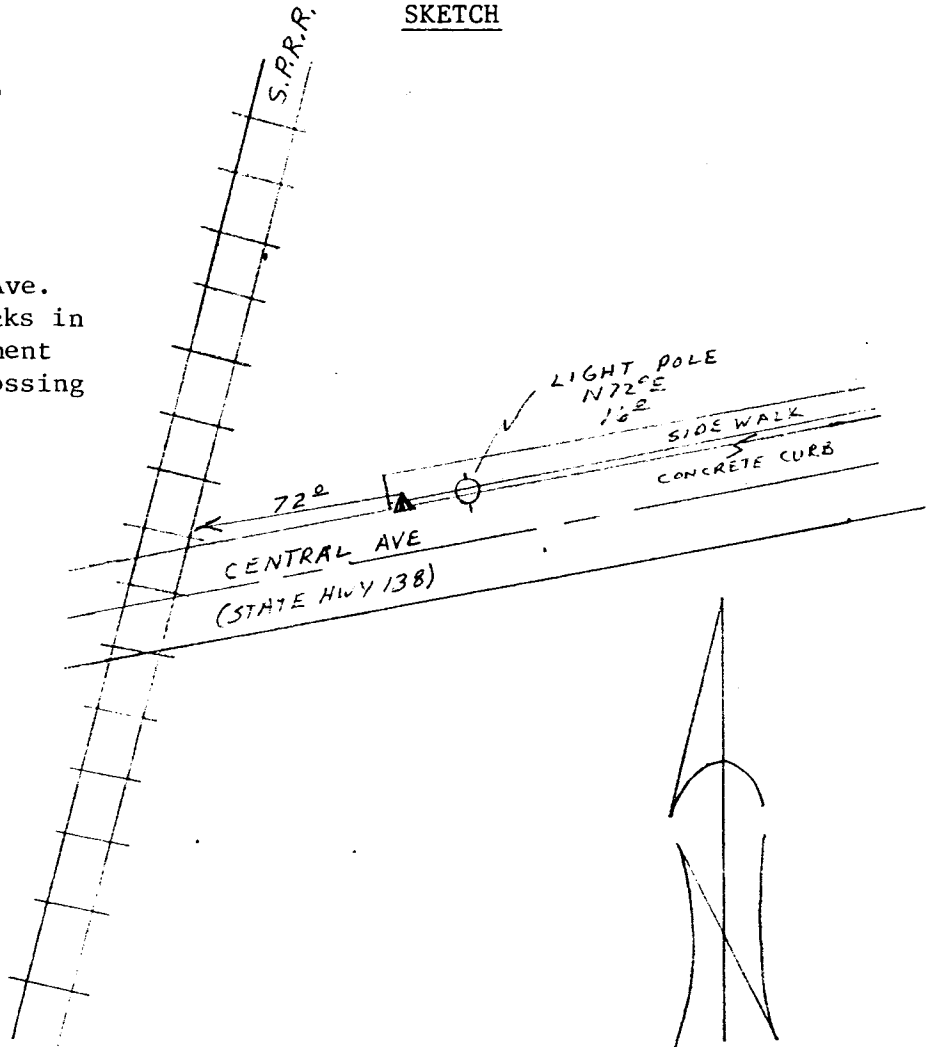

Reference Marks:

Note: For further information, contact the Douglas County Surveyor's Office, Room 205  
Douglas County Justice Building, Roseburg, OR 97470. Phone 440-4278. Douglas  
County residents outside the Roseburg calling area, dial toll free 1-800-452-0991.