

OFFICE OF THE
DOUGLAS COUNTY SURVEYOR

Station: I 9 T 30 S, R 6 W, Sec 32

Set By (Agency): USGS

Date Set: 1903

Recovered By RWS, SJF



Date Recovered 11/7/88

Recovered By _____

Date Recovered _____

Recovered By _____

Date Recovered _____

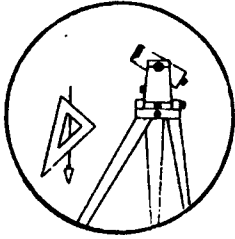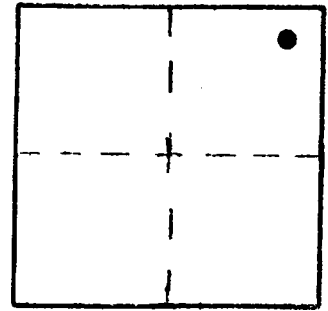

I-016

VERTICAL CONTROL NGVD 29 CORPSCON 6 NAVD 88 726.088 FT

Elevation: 722.663 NGS Line # 6 USGS Line # _____ OSHD Line # _____

Precision: 1st Agency: USC&GS Proj. # 2013 Date: 1957

HORIZONTAL CONTROL

South Zone State Plane Coordinates: Y(Northing) _____ X(Easting) _____

Precision: _____ Agency: _____ Proj. # _____ Date: _____

Approximate Geographic Position: Latitude _____ Longitude _____


DESCRIPTION and TO REACH

SKETCH

A 3 3/4 in. dia. USGS disk stamped "721 B 1903"
set in a 1 ft. square topped concrete post
protruding 9 in. above ground.

TO REACH:

From the intersection of Cow Creek Rd. (Co.Rd.#39)
and Riddle By-Pass Rd. (Co.Rd. #263) in T30S,R6W,
Sec.23, proceed southwesterly along Cow Creek Rd.
approximately 2.4 miles to Nickel Mountain Rd. and
S.P.R.R. tracks crossing County Rd., proceed westerly
along S.P.R.R. tracks approximately 0.9 miles to
monument on right.

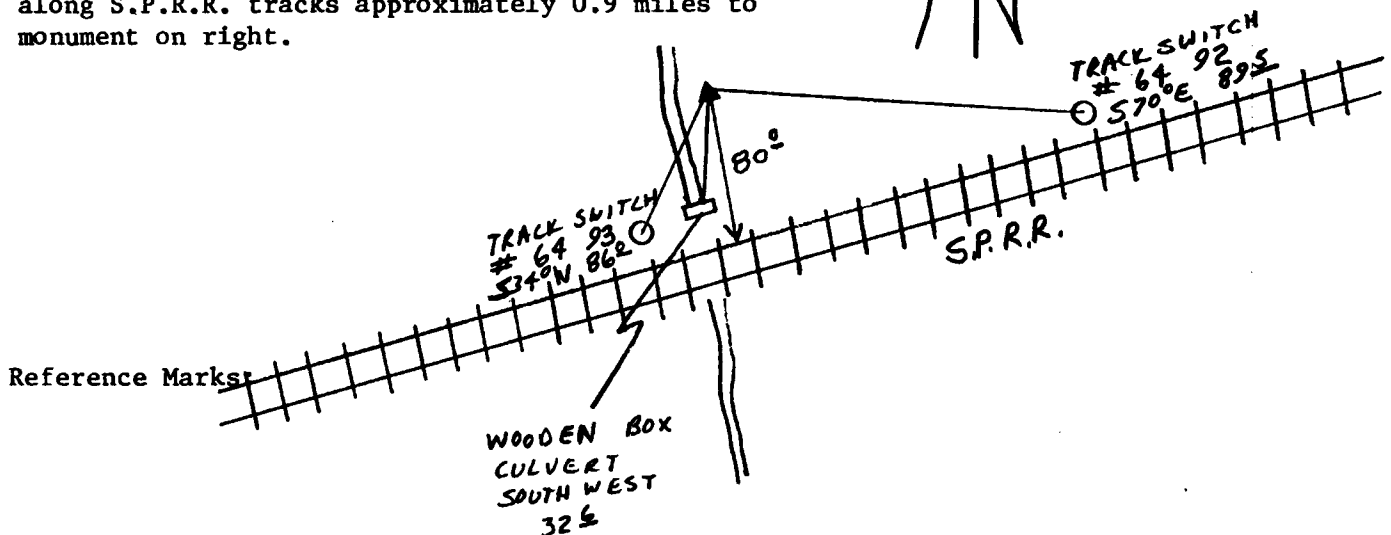

Note: For further information, contact the Douglas County Surveyor's Office, Room 205
Douglas County Justice Building, Roseburg, OR 97470. Phone 440-4278. Douglas
County residents outside the Roseburg calling area, dial toll free 1-800-452-0991.