



OFFICE OF THE  
DOUGLAS COUNTY SURVEYOR

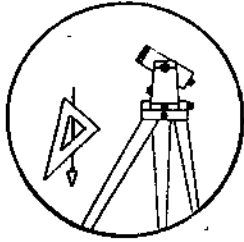

Station: J 612 T 21 S, R 12W , Sec 26  
Set By (Agency): DCSO  
Date Set: 1967  
Recovered By GQ--RWS  
Date Recovered 1-20-82  
Recovered By \_\_\_\_\_  
Date Recovered \_\_\_\_\_  
Recovered By \_\_\_\_\_  
Date Recovered \_\_\_\_\_

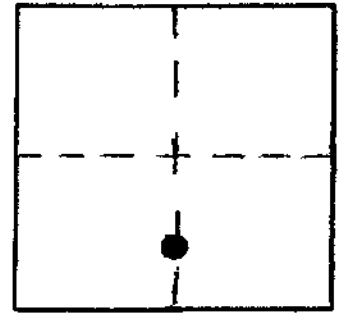

J ~~612~~  
010

VERTICAL CONTROL

Elevation: 17.52 NGS Line # \_\_\_\_\_ USGS Line # \_\_\_\_\_ OSHD Line # 93C  
Precision: 3rd Agency: DCSO Proj. # 2006 Date: 1989

HORIZONTAL CONTROL

South Zone State Plane Coordinates: Y(Northing) \_\_\_\_\_ X(Easting) \_\_\_\_\_

Precision: \_\_\_\_\_ Agency: \_\_\_\_\_ Proj. # \_\_\_\_\_ Date: \_\_\_\_\_


Approximate Geographic Position: Latitude \_\_\_\_\_ Longitude \_\_\_\_\_

DESCRIPTION and TO REACH

SKETCH

Found: A standard Hwy. Dept. disk set in concrete bridge curb. Disk is 2.5 ft. in from S.E. corner of bridge over slough. Disk is stamped "J 612 1967".

To reach: From the intersection of Hwy. 101 & Co Rd. #48 (in sec. 26 T21S R12W) proceed easterly 0.25 miles along Rd. #48 to monument on the right.

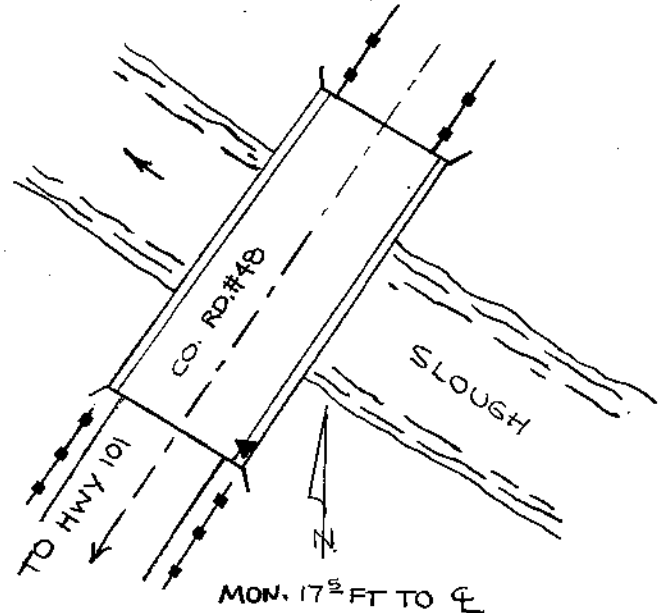

Reference Marks:

Note: For further information, contact the Douglas County Surveyor's Office, Room 205 Douglas County Justice Building, Roseburg, OR 97470. Phone 440-4278. Douglas County residents outside the Roseburg calling area, dial toll free 1-800-452-0991.