



OFFICE OF THE
DOUGLAS COUNTY SURVEYOR

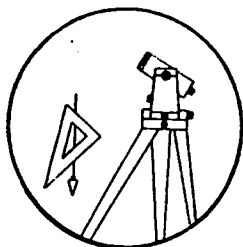

DESIG. J-011

Station: J 675 T 28 S, R 6 W , Sec 10
Set By (Agency): O.S.H.D.
Date Set: 1978
Recovered By RS,SJF
Date Recovered June 21, 1984
Recovered By ED OK 6/95 PER 1995-0017A8
DCSO 10/99
Date Recovered _____
Recovered By _____
Date Recovered _____

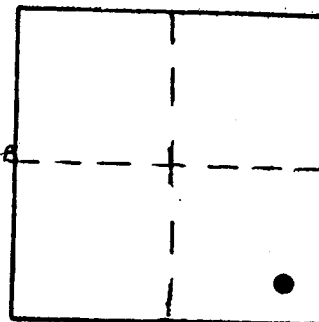

VERTICAL CONTROL CORPSCON6 NAVD88 537.69 FT.

Elevation: 534.25 NGS Line # _____ USGS Line # _____ OSHD Line # 6

Precision: 3rd. Agency: O.S.H.D. Proj. # CS 66/45 Date: 1978 10/99

HORIZONTAL CONTROL SEE CS 65/31-32 SURVEY BY HOEKSTRA FOR HORIZONTAL VALUES

South Zone State Plane Coordinates: Y(Northing) 551469 X(Easting) 4151185

Precision: GIS SCALED Agency: DCSO Proj. # _____ Date: 2014

Approximate Geographic Position: Latitude 43 08 37.1 Longitude 123 23 053


DESCRIPTION and TO REACH

SKETCH

An O.S.H.D. disk stamped "J 675"
set in a 1 foot square concrete post
flush with the ground.

TO REACH:

Go to the intersection of State
Highway 99 and S. W. Landers Avenue (Co.Rd.#153)
in T28S,R6W,Sec. 10.

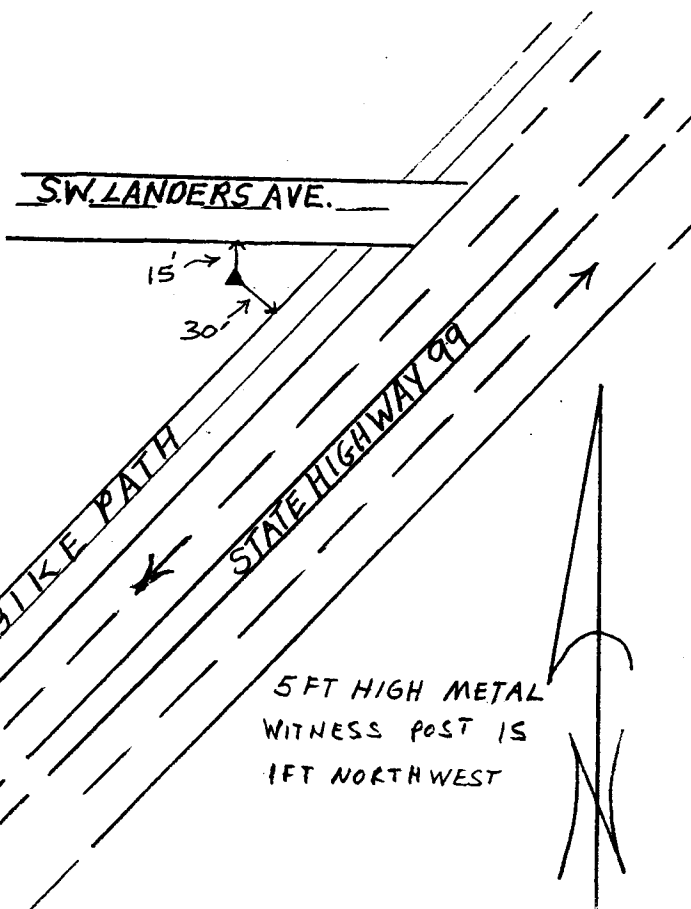

Reference Marks:

Note: For further information, contact the Douglas County Surveyor's Office, Room 205
Douglas County Justice Building, Roseburg, OR 97470. Phone 440-4278. Douglas
County residents outside the Roseburg calling area, dial toll free 1-800-452-0991.