


OFFICE OF THE

DOUGLAS COUNTY SURVEYOR

NAD 754571.18 3949228.15
83 43°40'43" 124°10'32"

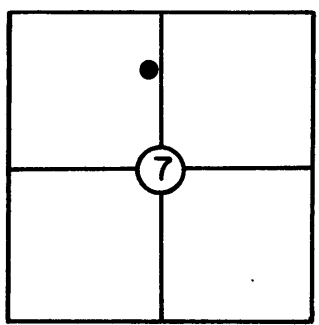

T 22 S, R 12 W., Sec. 7

Station: JENIFER

Set By (Agency): DCSO

Date: 1980

VERTICAL CONTROL **NGVD 29**

Elevation: 9.464 NGS(USC&GS) Line # _____ USGS Line # _____

Order
Of Precision 2nd Agency: DCSO Proj. #: 2007 CS 61/16 Date: 1981

HORIZONTAL CONTROL **NAD 27**


Oregon State Plane Coordinates: Y(Northing) 754,606.20 X(Easting) 1,028,267.48
(South Zone)

Order
Of Precision 1/15,000 Agency: DCSO Proj. #: 2008 Date: 1980

Approximate Geographic Position: Latitude= 43° 40' 43" Longitude= 124° 10' 28"

DESCRIPTION: From intersection of 9th Blvd.
and Beach Ave. go 0.3 mi. on Beach Ave.
to sta. Mon. is a DCSO BC set in conc.
sidewalk (See sketch). Pt. is on W. side
of street.

VICINITY: Salmon Harbor (Winchester Bay)

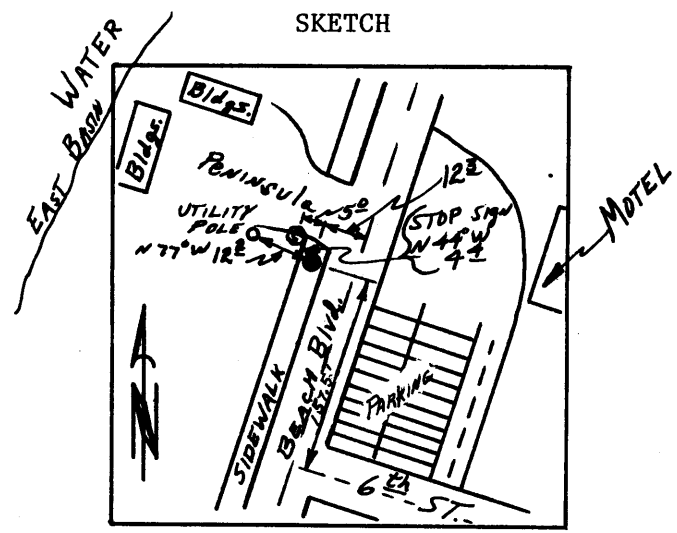

NOTE: For Possible Further Information On This Station, Please Contact The Douglas County Surveyors Office, Rm. 205 Douglas County Justice Bldg., Roseburg, OR. 97470 Phone 672-3311 Ext. 272. Douglas County residents outside the Roseburg calling area dial toll free 1-800-452-0991.