

OFFICE OF THE  
DOUGLAS COUNTY SURVEYOR

Station: Joyce Azimuth T 21 S, R 11W , Sec 16

Set By (Agency): USC & GS

Date Set: 1971

Recovered By GQ - TP


Date Recovered 1-25-82

Recovered By \_\_\_\_\_

Date Recovered \_\_\_\_\_

Recovered By \_\_\_\_\_

Date Recovered \_\_\_\_\_

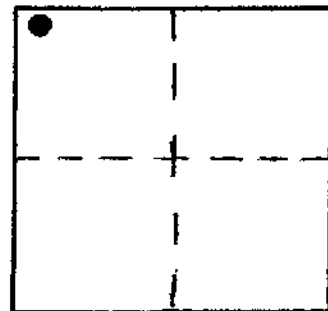

I-030 21S 11W 16  
JOYCE AZI

NAD 780087.17 3990243.43  
83 43°45'12" 124° 1'29"

VERTICAL CONTROL

Elevation: 11.32 NGS Line # \_\_\_\_\_ USGS Line # \_\_\_\_\_ OSHD Line # \_\_\_\_\_

Precision: 3rd Agency: DCSO Proj. # 2006 Date: 1989

HORIZONTAL CONTROL

 
South Zone State Plane Coordinates: Y(Northing) 780,122.53 X(Easting) 1,069,282.94

Precision: 1/25,000 Agency: DCSO Proj. # 2006 Date: 1973


Approximate Geographic Position: Latitude 43°45'13" Longitude 124°01'24"

DESCRIPTION and TO REACH

SKETCH

Found: A standard USC & GS Azimuth mark disk stamped "Joyce  1971".

To reach: From the intersection of Co. Rd. #195 and Co. Rd. #48 ( in sec. 19 T21S R11W) proceed northeasterly 2.7 miles along Rd. #48 to station on the right.

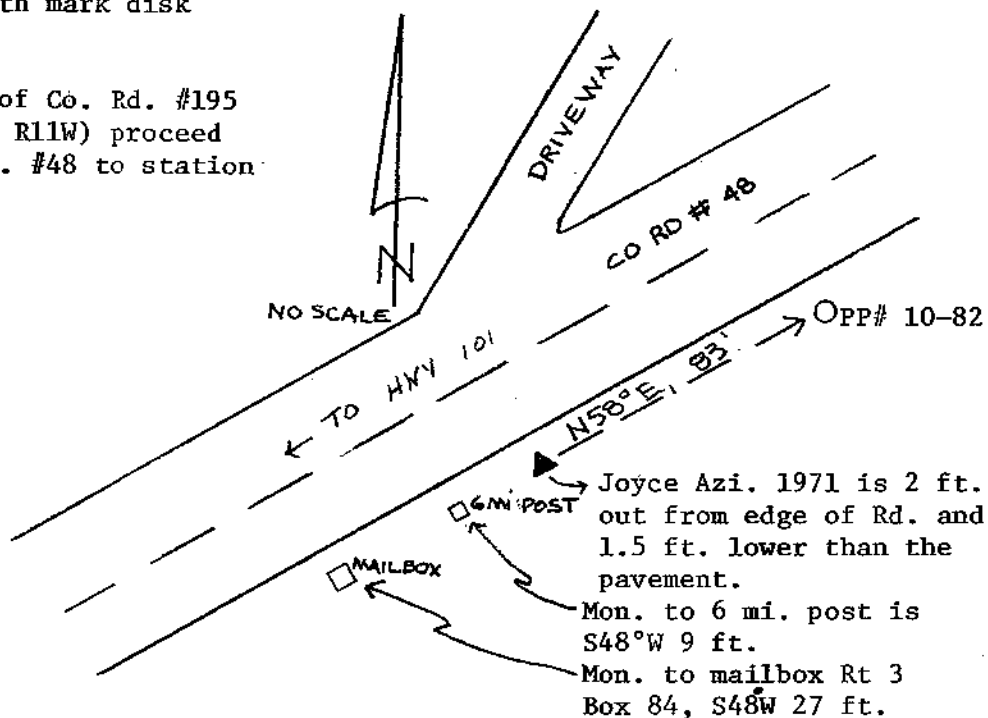

Reference Marks:

Note: For further information, contact the Douglas County Surveyor's Office, Room 205 Douglas County Justice Building, Roseburg, OR 97470. Phone 440-4278. Douglas County residents outside the Roseburg calling area, dial toll free 1-800-452-0991.