



OFFICE OF THE  
DOUGLAS COUNTY SURVEYOR

J-038

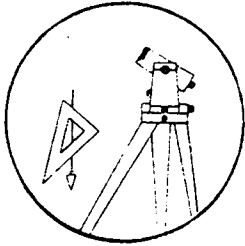

Station: JER 1 21 S, R 11 W, Sec 17A  
 Set By (Agency): DCSO  
 Date Set: 1988  
 Recovered By RWS, SJF  
 Date Recovered 12/13/88  
 Recovered By \_\_\_\_\_  
 Date Recovered \_\_\_\_\_  
 Recovered By \_\_\_\_\_  
 Date Recovered \_\_\_\_\_

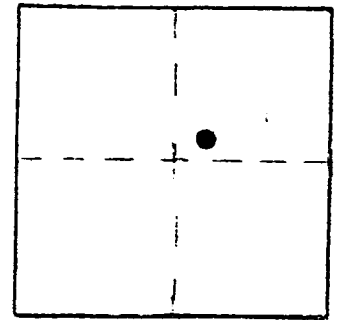

VERTICAL CONTROL

CORPCON 6 NAVD 88 16.73 FT

Elevation: 13.16 NGS Line # \_\_\_\_\_ USGS Line # \_\_\_\_\_ OSHD Line # \_\_\_\_\_  
 Precision: 3rd Agency: DCSO Proj. # 2006 Date: 1989

HORIZONTAL CONTROL

South Zone State Plane Coordinates: Y(Northing) 778239 X(Easting) 3988315  
 Precision: GIS SCALED Agency: DCSO Proj. # \_\_\_\_\_ Date: 2014  
 Approximate Geographic Position: Latitude \_\_\_\_\_ Longitude \_\_\_\_\_


DESCRIPTION and TO REACH

SKETCH

A DCSO disk stamped "JER 1988" set in a rock outcrop near toe of rock cut bank.

TO REACH:

From the intersection of Southside Rd. (Co.Rd.#195) and Smith River Rd. (Co.Rd.#48) in T21S,R11W,Sec.19, proceed easterly along Smith River Rd. approximately 2.25 miles to monument on left.

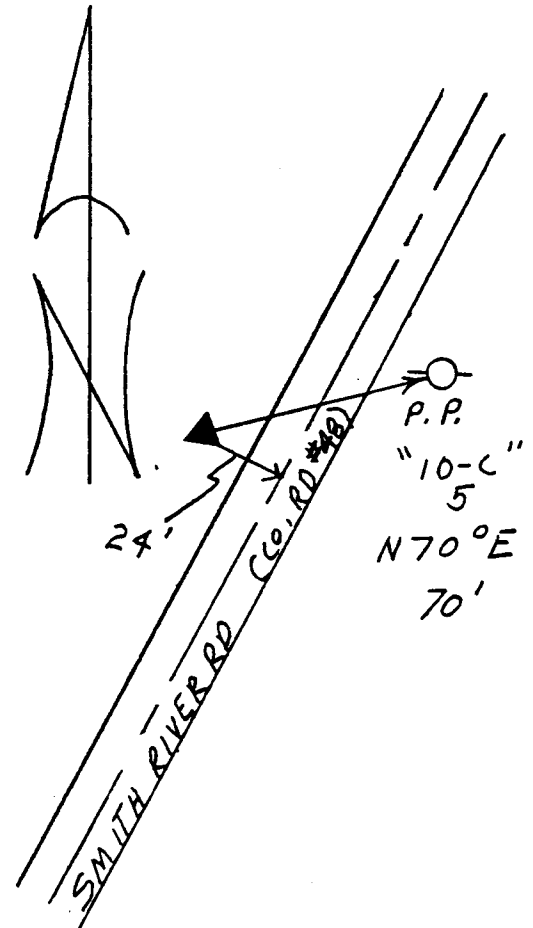

Reference Marks:

Note: For further information, contact the Douglas County Surveyor's Office, Room 205 Douglas County Justice Building, Roseburg, OR 97470. Phone 440-4278. Douglas County residents outside the Roseburg calling area, dial toll free 1-800-452-0991.