

Station: JENN



T 26 S, R 3W, Sec 32

Date Set: 1999

Set By (Agency): DCSO

Date Recovered: JUNE 30, 1999

Recovered By: RWS, SJF

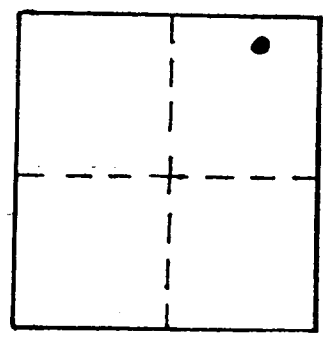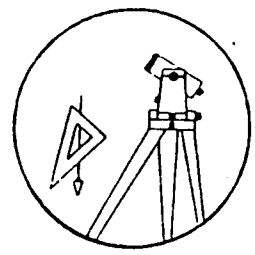

- Found
- New
- Reset
- Not Found
- Referenced
- Destroyed

DESIGNATION J-051

VERTICAL CONTROL

Elevation: 760.32 NGS Line # \_\_\_\_\_ USGS Line # \_\_\_\_\_ OSHD Line # \_\_\_\_\_

Precision: 3rd Agency: DCSO Proj. # 2007 Date: 1999

HORIZONTAL CONTROL CORPSCON6 NAVD88 763.89 FT. CS 66/56

South Zone O.C.S. 27: Y(Northing) \_\_\_\_\_ X(Easting) \_\_\_\_\_

South Zone O.C.S. 83: Y(Northing) 595103 X(Easting) 4235582

Precision: 615 SCALED Agency: DCSO Proj. # \_\_\_\_\_ Date: 2014

Approx. ~~NA 83~~ Geographic Position: Latitude 43°16'14" Longitude 123°04'26"

DESCRIPTION and TO REACH

A 2 3/8 INCH DIAMETER DCSO DRILL CAP STAMPED "JENN 1999" SET IN TOP OF RAISED CONCRETE BRIDGE CURB AT SOUTH SIDE AND WESTERLY END OF BRIDGE OVER SMALL STREAM.

FROM THE INTERSECTION OF BUCKHORN ROAD (Co. Rd. #17) AND LITTLE RIVER RD. (Co. Rd. #17C) IN T26S, R3W, SEC. 30, PROCEED SOUTHEASTERLY ALONG LITTLE RIVER RD. APPROXIMATELY 1.45 MILES TO MONUMENT ON RIGHT.

Reference Marks:

