

DOUGLAS COUNTY SURVEYOR'S OFFICE

GLS
R040921B
OFFSET

317° 210 FT VERT T 7 FT TO MON.


100-1104

Designation: J-052 Station: JOEL T 24 R 7W S 11 1/4 NE

Date Set: 2003 Set by (Agency): DCSO

Date Recovered: 3-26-03 Recovered by: RWS SJF

- Found New Reset
- Not Found Referenced Destroyed

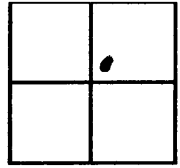

VERTICAL CONTROL

NGVD 29 Elevation: 246.95 Feet File # CS 67/1
 Precision: 3rd Agency: DCSO Project: 2007 Date: 2003

NAVD 88 Elevation: _____ Meters File # _____
 Precision: _____ Agency: _____ Project: _____ Date: _____

HORIZONTAL CONTROL - south zone

N _____ E _____ Datum/Adj.: 1927 Precision: GLS
 Lat: 43° 29' 59.9" Long: 123° 29' 39.7" Agency: DCSO File # R040921B Date: 2003

N _____ E _____ Datum/Adj.: _____ Precision: _____

Lat: _____ Long: _____ Agency: _____ File # _____ Date: _____

N _____ E _____ Datum/Adj.: _____ Precision: _____


Lat: _____ Long: _____ Agency: _____ File # _____ Date: _____

N _____ E _____ Datum/Adj.: _____ Precision: _____

Lat: _____ Long: _____ Agency: _____ File # _____ Date: _____

DESCRIPTION AND TO REACH

DCSO BRASS CAP STAMPED
"JOEL 2003" SET IN AN
EXPOSED ROCK 4 FT ABOVE
ROAD SURFACE. ROCK IS
3' X 2' X 1" OUT OF GROUND
FROM THE INTERSECTION OF BULLOCK
ROAD (CO RD #57) AND COUGAR CREEK
ROAD (CO RD #57C) IN T24S R7W
S1/4 AT TYPE, NEAR WESTERLY
END OF BULLOCK BRIDGE OVER
UMPOVA RIVER, PROCEED NORTH
WESTERLY ALONG BULLOCK ROAD
1.65 MILES TO MONUMENT ON
LEFT

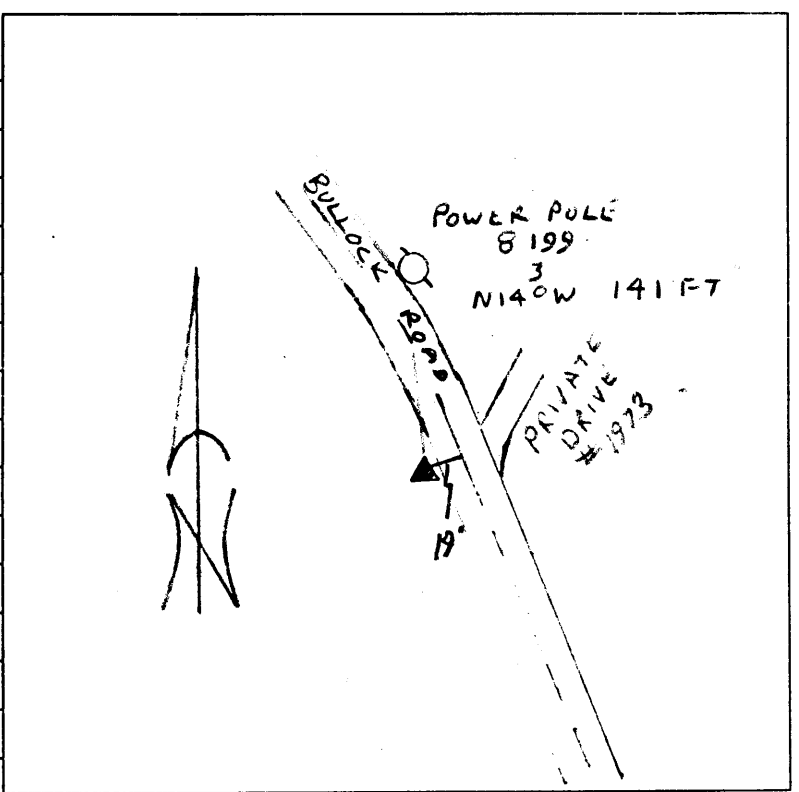



SCHOOL
BUS STOP
AHEAD

7. 27. 1999