

OFFICE OF THE
DOUGLAS COUNTY SURVEYOR

Station: K 739

T22S R5W Sec. 28

Date Set: 1987

Set By (Agency): NGS

DCSO Designation: K-039

Date Recovered: 8-93



Recovered By: RWS SJF

Date Recovered: _____

Recovered By: _____

Date Recovered: _____

Recovered By: _____

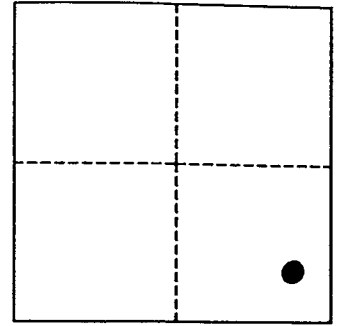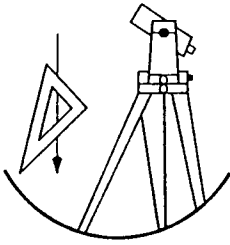

VERTICAL CONTROL

~~NGVD 29~~ NAVD 88 Elevation: 331.430 FEET NAVD 88 Elevation: 101.020 METERS

NGS Line # 125035 USGS LINE # _____ OSHD Line # _____ FILE # _____

Precision: 1ST ORDER Agency: NGS Proj: _____ Date: 1988

HORIZONTAL CONTROL

O.C.S. 27 Y(Northing): _____ O.C.S. 83 Y(Northing): 726638

(South Zone) X(Easting): _____ (South Zone) X(Easting): 4182127

Precision: GIS SCALED Agency: DCSO Proj: _____ Date: 2014

Approx. O.C.S. 27 Geographic Position: Latitude: 43°37'38" Longitude: 123°17'29"

Approx. O.C.S. 83 Geographic Position: Latitude: _____ Longitude: _____

Found: A 9/16 inch diameter stainless steel rod set under a 6 - 7/8 inch diameter aluminum collar and access cover, set in concrete, stamped "K 739 1987".

To reach: From the intersection of Main St. and Eagle Valley Rd. (Co. Rd. #389) formerly State Hwy 99 in T23S R5W Sec 3 proceed northerly approx. 2.0 miles along Eagle Valley Rd. to monument on right.

