


OFFICE OF THE
DOUGLAS COUNTY SURVEYOR

Station: KURT
Date Set: 1999
Set By (Agency): DCSO
Date Recovered: 7/7/99
Recovered By: RWS SJF


T 27 S, R 3W, Sec 14

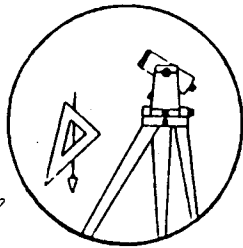

13

K-047

- Found
- New
- Reset
- Not Found
- Referenced
- Destroyed

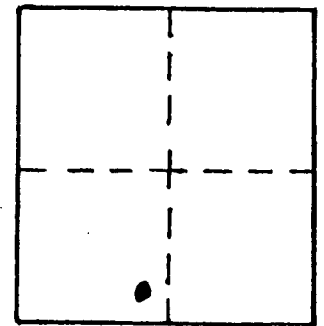

VERTICAL CONTROL

Elevation: 980.92 NGS Line # _____ USGS Line # _____ OSHD Line # _____
Precision: 3rd Agency: DCSO Proj. # 2007 Date: 1999

HORIZONTAL CONTROL CORPSCON6 NAVD88 984.54 FT. CS 66/56

South Zone O.C.S. 27: Y(Northing) _____ X(Easting) _____

South Zone O.C.S. 83: Y(Northing) 574286 X(Easting) 4249187

Precision: GIS SCALED Agency: DCSO Proj. # _____ Date: 2014

Approx. ⁰⁶⁵²⁷~~NAD 83~~ Geographic Position: Latitude 43°12'54" Longitude 123°01'14"

DESCRIPTION and TO REACH

A 2 3/8 INCH DIAMETER DCSO DRILL CAP STAMPED "KURT 1999" SET FLUSH NEAR HIGH POINT OF VERY LARGE BED-ROCK OUTCROPPING, WHICH FORMS THE WESTERLY BANK OF CAVITT CREEK AT THIS LOCALE.

FROM THE INTERSECTION OF CAVITT CREEK ROAD (Co. Rd. #82) AND NEW BRIDGE RD (Co. Rd. #82A) IN T27S, R3W SEC 11 PROCEED SOUTHERLY ALONG NEW BRIDGE RD. APPROXIMATELY 1.3 MILES TO MONUMENT ON LEFT AT BEND IN STREAM. MONUMENT IS APPROX 0.1 MILES NORTHERLY OF PRIVATE BRIDGE OVER CAVITT CRK

Reference Marks:

