


**DOUGLAS COUNTY SURVEYOR'S OFFICE**

Designation: K-052 Station: KINDA T 22S R 07W S 19 ¼ D

Date Set: OCTOBER, 2008 Set by (Agency): DCSO

Date Recovered: 12/10/08 Recovered by: SJF, JAP

- Found                       New                       Reset  
 Not Found                   Referenced             Destroyed

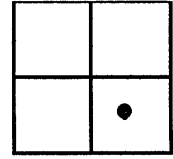

VERTICAL CONTROL

NGVD 29 Elevation: 135.29 Feet                      File # \_\_\_\_\_

Precision: 3RD ORDER                      Agency: DCSO

Project: 2006                      Date: 11/19/08

NAVD 88 Elevation: \_\_\_\_\_ Meters                      File # \_\_\_\_\_

Precision: \_\_\_\_\_                      Agency: \_\_\_\_\_

Project: \_\_\_\_\_                      Date: \_\_\_\_\_

HORIZONTAL CONTROL - south-zone

N \_\_\_\_\_ E \_\_\_\_\_ Datum/Adj.: \_\_\_\_\_ Precision: \_\_\_\_\_

Lat: \_\_\_\_\_ Long: \_\_\_\_\_ Agency: \_\_\_\_\_ File # \_\_\_\_\_ Date: \_\_\_\_\_

DESCRIPTION AND TO REACH

A 3 INCH DIAM. PCSO DRILL CAP STAMPED "KINDA 2008" SET IN EXPOSED SECTION OF ROCK LEDGE JUST OFF OF, AND 10 INCHES HIGHER THAN NARROW PAVED HIGHWAY SHOULDER.

FROM THE INTERSECTION OF STATE HIGHWAY 138 W AND STATE HIGHWAY 38 IN T22S, R07W, SECTION 29 PROCEED NW'LY ALONG STATE HIGHWAY 38 APPROX. 0.5 MILES TO MONUMENT ON RIGHT.

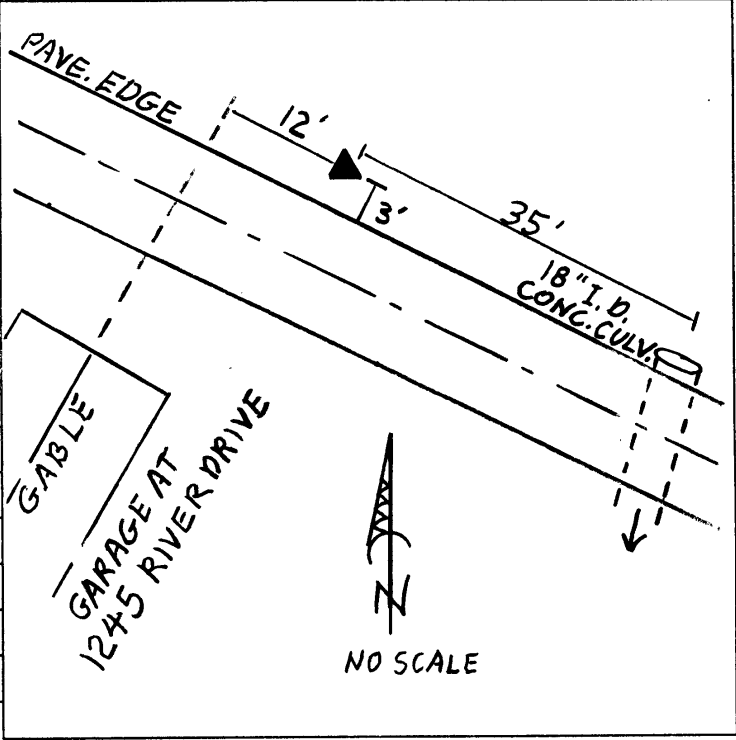


PHOTO FILE NAME

LOCATION

100-1358 (7/22/09 renamed)  
to K-052

M-121013A

PROCESSED BY: \_\_\_\_\_

DATE: \_\_\_\_\_



12.10.2008