



OFFICE OF THE
DOUGLAS COUNTY SURVEYOR

L-001

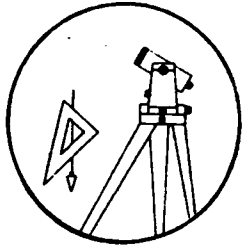

Station: L-9
Set By (Agency): USC&GS
Date Set: 1920
Recovered By JP-RS
Date Recovered 2-17-82
Recovered By _____
Date Recovered _____
Recovered By _____
Date Recovered _____

T 30 S, R 6W , Sec 24

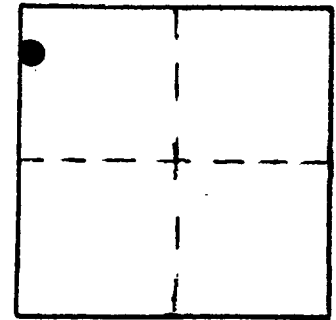

VERTICAL CONTROL CORPSCON6 NAVD88 709.172 FT.

Elevation: 705.753 NGS Line # 130 USGS Line # _____ OSHD Line # _____
Precision: 2nd Agency: USC&GS Proj. # _____ Date: 1957

HORIZONTAL CONTROL

South Zone State Plane Coordinates: Y(Northing) 482136 X(Easting) 4154498
Precision: GIS SCALED Agency: DCSO Proj. # _____ Date: 2014


Approximate Geographic Position: Latitude _____ Longitude _____

DESCRIPTION and TO REACH

SKETCH

Found: A standard USC&GS disk stamped "L-9 1920" set in concrete headwall, 4' below the S.P.R.R. tracks.

To reach: From the intersection of Main St. and Fifth Ave. in Riddle (T30S R6W sec. 24), proceed Northeasterly along Fifth St. 0.2 mi. to monument on the left, 300ft. - off Fifth St. 4ft. below the railroad tracks.

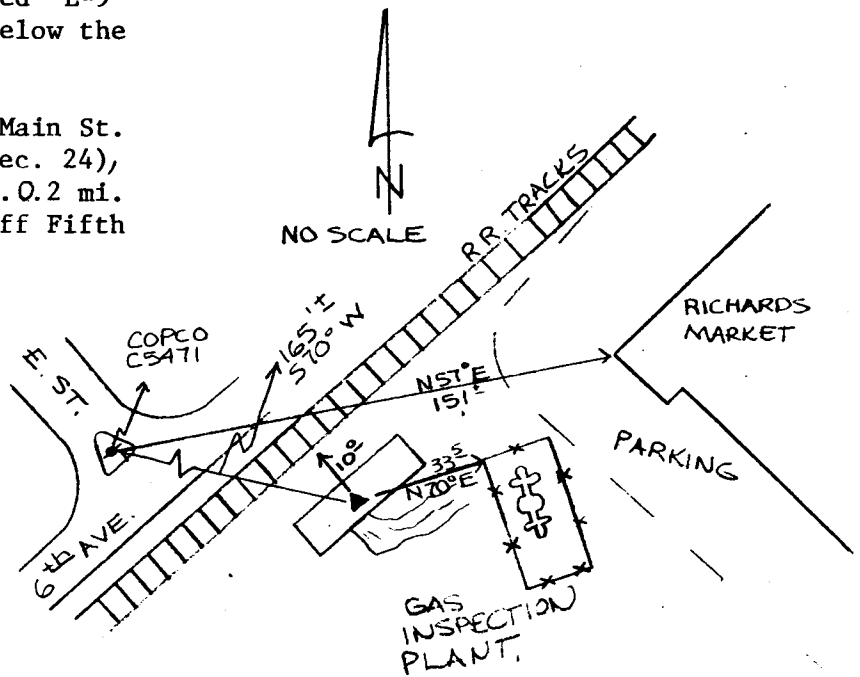

Reference Marks:

Note: For further information, contact the Douglas County Surveyor's Office, Room 205 Douglas County Justice Building, Roseburg, OR 97470. Phone 440-4278. Douglas County residents outside the Roseburg calling area, dial toll free 1-800-452-0991.