


OFFICE OF THE

DOUGLAS COUNTY SURVEYOR

1-004
L 55

225 8W 16

NAD 741519.05 4086430.70
83 43°39'29" 123°39'20"

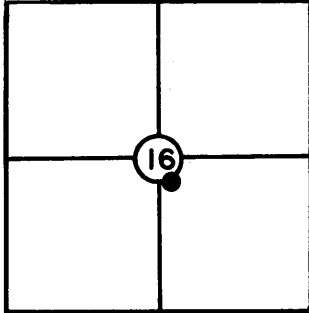

T 22 S, R 8W, Sec. 16

Station: L 55

Set By (Agency): USC & GS

Date: 1930

NGVD 29

VERTICAL CONTROL

Elevation: 90.311 NGS(USC&GS) Line # 16 USGS Line # _____

Order
Of Precision 1st Agency: USC & GS Proj. #: _____ Date: 1947

HORIZONTAL CONTROL

NAO 27


Oregon State Plane Coordinates: Y(Northing) 741,55.3.91 X(Easting) 1,165,470.40
(South Zone)

Order
Of Precision 1/10,000 Agency: DCSO Proj. #: 2006 Date: 1972

Approximate Geographic Position: Latitude= _____ Longitude= _____

DESCRIPTION: About 130 ft. N. of a small
culvert, about 65 ft. E. of the Hwy., 35 ft.
E. of the Hwy. centerline and set in the top
of a concrete post projecting 6" above ground.
A standard disk stamped "L 55 1930".

SKETCH

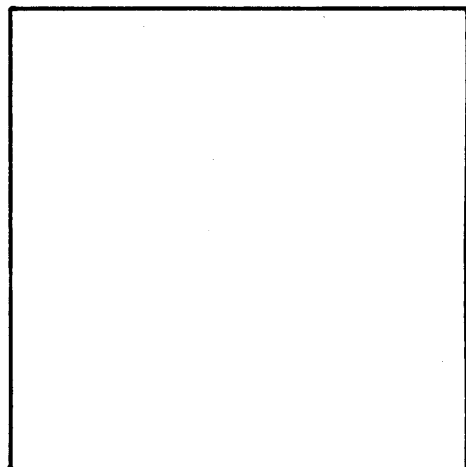

VICINITY: Approx. 7.2 mi. W. of Elkton.

NOTE: For Possible Further Information On This Station, Please Contact The Douglas County Surveyors Office, Rm. 205 Douglas County Justice Bldg., Roseburg, OR. 97470 Phone 672-3311 Ext. 272.. Douglas County residents outside the Roseburg calling area dial toll free 1-800-452-0991.