



Station: LIGHTS
 Date Set: 1998
 Set By (Agency): DCSO
 Date Recovered: 11-9-95
 Recovered By: RWS SJR

T 26 S, R 6W, Sec 32

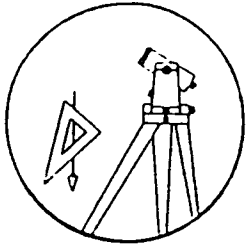

L-076

- | | |
|-------------------------------------|---|
| <input type="checkbox"/> Found | <input checked="" type="checkbox"/> New |
| <input type="checkbox"/> Reset | <input type="checkbox"/> Not Found |
| <input type="checkbox"/> Referenced | <input type="checkbox"/> Destroyed |

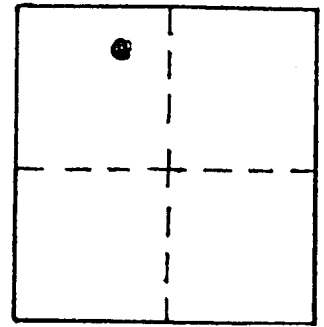

VERTICAL CONTROL

Elevation: 391.08 NGS Line # _____ USGS Line # _____ OSHD Line # _____

Precision: 3rd Agency: DCSO Proj. # 2007 Date: 1998

HORIZONTAL CONTROL CORPSCON6 NAVD88 394.53 FT. CS FILE # 66/031

South Zone O.C.S. 27: Y(Northing) _____ X(Easting) _____

South Zone O.C.S. 83: Y(Northing) 597847 X(Easting) 4138752

Precision: GIS SCALED Agency: DCSO Proj. # _____ Date: 2014

Approx. NAD 83 Geographic Position: Latitude 43°16'09" Longitude 123°26'15"

DESCRIPTION and TO REACH

DCSO BRASS CAP STAMPED "LIGHTS 1998" IS AT NW COR. OF A 10' X 30' CONCRETE PAD

FROM THE INTERSECTION OF OLD GARDEN VALLEY ROAD (CO. RD # 6A) AND RIVER FORKS PARK ROAD IN T26S R6W SEC. 29 PROCEED SOUTHERLY ALONG RIVER FORKS PARK ROAD 0.3 MILE TO CARE TAKER MOBILE HOME AND MONUMENT.

(CO. RD # 283)

Reference Marks:

