

write/rain

OFFICE OF THE
DOUGLAS COUNTY SURVEYOR

Station: LOCKWOOD


T 28 S, R 7W, Sec 31

Date Set: 2001


Set By (Agency): DCSO

Date Recovered: 9-9-01

Recovered By: RWS, SJF

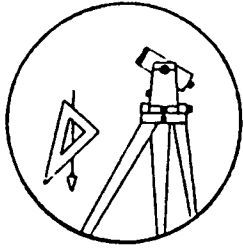

- Found
- Reset
- Referenced
- New
- Not Found
- Destroyed

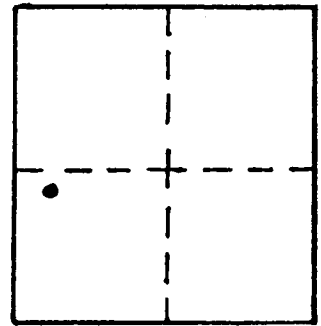

L-081

VERTICAL CONTROL NGVD 29

Elevation: 711.42 NGS Line # _____ USGS Line # _____ OSHD Line # _____

Precision: 3rd Agency: DCSO Proj. # 2007 Date: 2001

HORIZONTAL CONTROL CORPSCON6 NAVD88 714.85 FT.

South Zone O.C.S. 27: Y(Northing) _____ X(Easting) _____

South Zone O.C.S. 83: Y(Northing) 535137 X(Easting) 4099176

Precision: GIS SCALED Agency: DCSO Proj. # _____ Date: 2014

Approx. N27 Geographic Position: Latitude 43° 05' 37" Longitude 123° 34' 39"

DESCRIPTION and TO REACH

DCSO DRILL CAP SET IN NORTH EAST CONCRETE BRIDGE WING WALL

FROM THE INTERSECTION OF RESTON RD (CO. RD #50) AND LOCKWOOD RD. (CO. RD #250 IN T28S R7W SEC 31 PROCEED SOUTHWESTERLY ALONG LOCKWOOD RD. 0.1 MILES TO CONCRETE BRIDGE AND MONUMENT ON LEFT.

Reference Marks:

