


**DOUGLAS COUNTY SURVEYOR'S OFFICE**

Designation: 0-042 Station: ODOT CONTROL 101 T 28 S R 6 W S 21 AC 1/4 NE

Date Set: N/A Set by (Agency): O.D.O.T.

Date Recovered: AUG. 2005 Recovered by: S. FLAUSE, J. PIKE

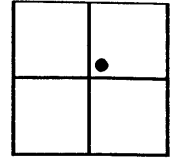

- Found       New       Reset  
 Not Found       Referenced       Destroyed

VERTICAL CONTROL

NGVD 29 Elevation: 533.36 Feet      File # \_\_\_\_\_  
 Precision: 3rd      Agency: DCSO      Project: CS 67/17      Date: 2005  
 NAVD 88 Elevation: \_\_\_\_\_ Meters      File # \_\_\_\_\_  
 Precision: \_\_\_\_\_      Agency: \_\_\_\_\_      Project: \_\_\_\_\_      Date: \_\_\_\_\_


HORIZONTAL CONTROL - south zone

N 543887.0      E 4143719.9      Datum/Adj.: NAD 83      Precision: 615  
 Lat: 43°07'19.0"      Long: 123°24'47.2"      Agency: DCSO      File # CS.67/17      Date: 8/05  
 N \_\_\_\_\_      E \_\_\_\_\_      Datum/Adj.: \_\_\_\_\_      Precision: \_\_\_\_\_  
 Lat: \_\_\_\_\_      Long: \_\_\_\_\_      Agency: \_\_\_\_\_      File # \_\_\_\_\_      Date: \_\_\_\_\_  
DESCRIPTION AND TO REACH

A 1 1/8" DIA. COPPER DISK STAMPED  
"O.D.O.T. CONTROL 101" SET  
FLUSH IN SIDEWALK.

MONUMENT LIES IN TRAFFIC ISLAND  
(WITH STATUE OF CHEETAH) AT THE  
INTERSECTION OF MAIN ST. (HWY 99)  
AND SW DOUGLAS AVE. (HWY 42)  
IN DOWNTOWN WINSTON IN THE  
NE 1/4 OF SECTION 21, T28S, R6W.

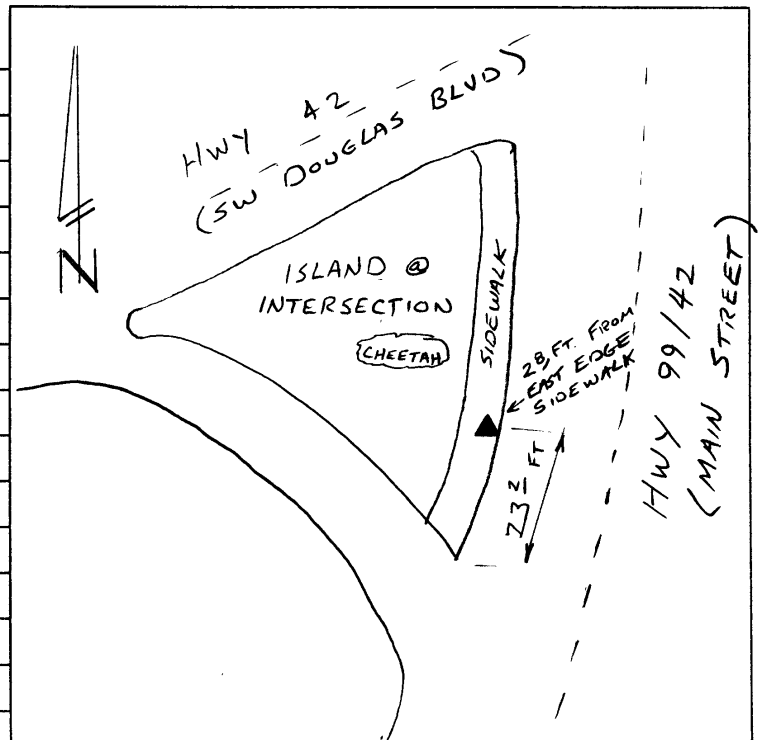

**PHOTO FILE NAME**

**LOCATION**

GPS FILE - MOB1714A

PICTURE FILE - # 100-1256

PROCESSED BY: \_\_\_\_\_

DATE: \_\_\_\_\_