

OFFICE OF THE  
DOUGLAS COUNTY SURVEYOR

MYRTLE CREEK BASE LINE

Station: EAST BASE T 29 S, R 5 W , Sec 22

Set By (Agency): DCSO

Date Set: 1978

Recovered By RS, SJF



Date Recovered 1/91; 12/92

Recovered By \_\_\_\_\_

Date Recovered \_\_\_\_\_

Recovered By \_\_\_\_\_

Date Recovered \_\_\_\_\_

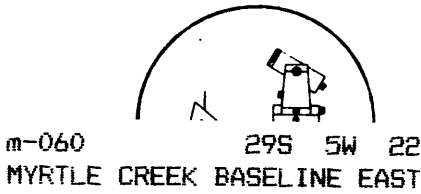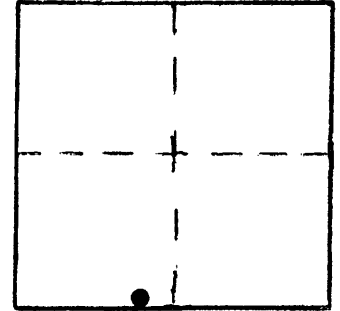

m-060 295 5W 22  
MYRTLE CREEK BASELINE EAST

NAD 508252.76 4178102.97  
83 43° 1'39" 123°16'48"

NGVD 29  
VERTICAL CONTROL 668 317

Elevation: 6.1 NGS Line # \_\_\_\_\_ USGS Line # \_\_\_\_\_ OSHD Line # \_\_\_\_\_

Precision: 2nd Agency: DCSO Proj. # 2007 Date: 1991

HORIZONTAL CONTROL OCS 27

South Zone State Plane Coordinates: Y(Northing) 508,288.34 X(Easting) 1,257,144.51

Precision: -1/25,000 Agency: DCSO Proj. # 2008 Date: 1978

Approximate Geographic Position: Latitude 43°01'39" Longitude 123°16'44"

DESCRIPTION and TO REACH


SKETCH

DESCRIPTION:

A DCSO disk stamped "MYRTLE CREEK BASELINE EAST BASE 1978"  
set flush in a concrete curb.

TO REACH:

From the intersection of Spruce Ave. and Division St.  
in Myrtle Creek, proceed east along Division St. 382 ft.  
to monument on right.

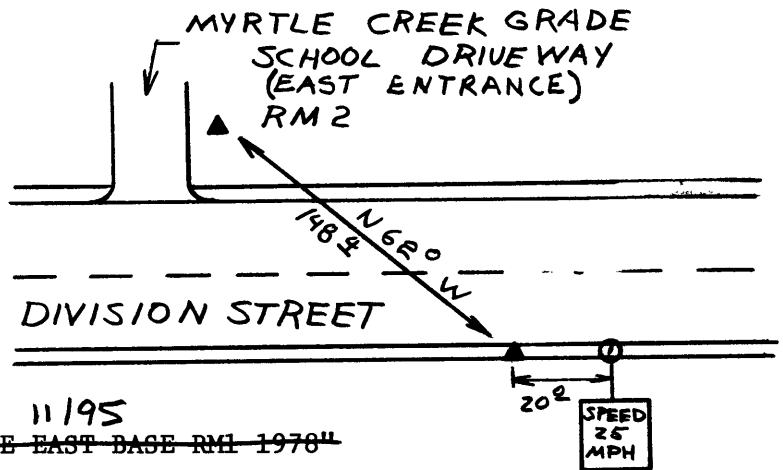

Reference Marks: RM 1 DESTROYED 11/95  
~~A DCSO disk stamped "MYRTLE CREEK BASELINE EAST BASE RM1 1978"  
bears N 39°00'10" E, 61.59 ft. (grid).~~

A DCSO disk stamped "MYRTLE CREEK BASELINE EAST BASE RM2 1978"  
bears N 59° 39'00" W, 148.43 ft. (grid).

Note: For further information, contact the Douglas County Surveyor's Office, Room 205  
Douglas County Justice Building, Roseburg, OR 97470. Phone 440-4278. Douglas  
County residents outside the Roseburg calling area, dial toll free 1-800-452-0991.