


M-101

OFFICE OF THE  
DOUGLAS COUNTY SURVEYOR

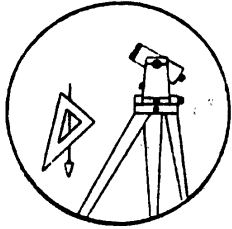

Station: MADRONE

T 22 S, R 4W, Sec 34


Date Set: 1997

Set By (Agency): DCSO

Date Recovered: 2-19-97

Recovered By: POS SJF

- Found
- Reset
- Referenced
- New
- Not Found
- Destroyed

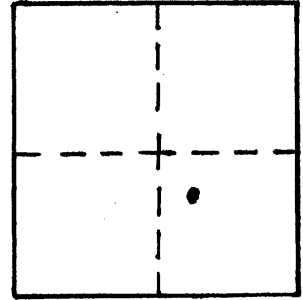

VERTICAL CONTROL NGVD 29

Elevation: 810.33 NGS Line # \_\_\_\_\_ USGS Line # \_\_\_\_\_ OSHD Line # \_\_\_\_\_

Precision: 3<sup>rd</sup> Agency: DCSO Proj. # 2007 Date: 1997

HORIZONTAL CONTROL

South Zone O.C.S. 27: Y(Northing) \_\_\_\_\_ X(Easting) \_\_\_\_\_

South Zone O.C.S. 83: Y(Northing) \_\_\_\_\_ X(Easting) \_\_\_\_\_

Precision: \_\_\_\_\_ Agency: \_\_\_\_\_ Proj. # \_\_\_\_\_ Date: \_\_\_\_\_

Approx. 1927 Geographic Position: Latitude 43°36'37" Longitude 123°09'15"

DESCRIPTION and TO REACH

8" DIA BY 42" LONG CONCRETE FILLED BULLETIN  
WITH A DCSO BRASS CAP STAMPED "MADRONE 1997"  
PROTRUDES 4" ABOVE GROUND

FROM THE INTERSECTION OF CO. RD #8  
(SCOTT'S VALLEY ROAD AND CO. RD #7 ELK HEAD  
ROAD IN T22S R4W SECTION 31 PULL  
NORTHWESTWARD ALONG SCOTT'S VALLEY ROAD  
4.05 MILE TO MONUMENT ON LEFT.

Reference Marks:

