

OFFICE OF THE
DOUGLAS COUNTY SURVEYOR

Station: N 496


T 25 S, R 7W, Sec 27

Date Set: 1942

Set By (Agency): USC+GS


Date Recovered: 3-1-00

Recovered By: RWS SJF

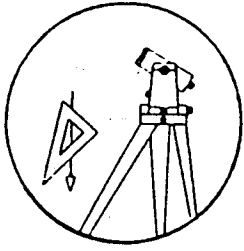

N-008

- | | |
|---|------------------------------------|
| <input checked="" type="checkbox"/> Found | <input type="checkbox"/> New |
| <input type="checkbox"/> Reset | <input type="checkbox"/> Not Found |
| <input type="checkbox"/> Referenced | <input type="checkbox"/> Destroyed |

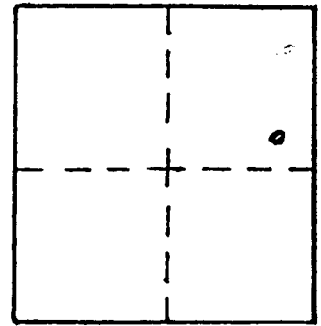

VERTICAL CONTROL

Elevation: 350.570 NGS Line # 98 USGS Line # _____ OSHD Line # _____

Precision: 2nd Agency: USC+GS Proj. # _____ Date: 1956

HORIZONTAL CONTROL CORPSCON6 NAVD88 354.08 FT. CS66153

South Zone O.C.S. 27: Y(Northing) _____ X(Easting) _____

South Zone O.C.S. 83: Y(Northing) 634609 X(Easting) 4121693

Precision: GIS SCALED Agency: DCSO Proj. # _____ Date: 2014

Approx. NAD ⁸³ Geographic Position: Latitude 43° 22' 07" Longitude 123° 30' 23"

DESCRIPTION and TO REACH

FROM THE INTERSECTION OF MELIQUA RD (CO. RD #13A)
AND HUBBARD CRK RD (CO. RD #6) IN T25S R7W
SEC. 26 PROCEED WESTERLY ALONG HUBBARD
CRK ROAD 1.1 MILES TO MONUMENT ON RIGHT.

USC+GS BRASS CAP SET IN A CONCRETE
POST, PROTRUDES 3" ABOVE GROUND MARKED
" N 496 1942 ".

Reference Marks:

