


OFFICE OF THE
DOUGLAS COUNTY SURVEYOR

n-015 22S 4W 18
NATHAN
NAD 715300.24 4204449.18
SB 431351.5" 123112132"

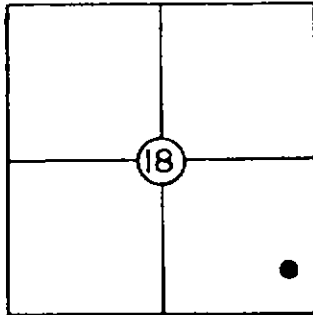

T 22 S, R 4W, Sec. 18
Station: NATHAN
Set By (Agency): OSHD
Date: 1979

VERTICAL CONTROL

Elevation: _____ NGS(USC&GS) Line # _____ USGS Line # _____

Order
Of Precision _____ Agency: _____ Proj. #: _____ Date: _____

HORIZONTAL CONTROL


Oregon State Plane Coordinates: Y(Northing) 735,334.67 X(Easting) 1,283,488.52
(South Zone)

Order
Of Precision 1/25,000 Agency: DCSO Proj. #: 2008 Date: 1979

Approximate Geographic Position: Latitude= _____ Longitude= _____

DESCRIPTION: OSHD Disk set in Southerly end
of 15 ft. conc. headwall 10 ft. above "Curtis
Creek Rd.", 23.4 ft. Easterly of I-5 North
bound centerline. Cap stamped "DCSO NATHAN 1979".

SKETCH

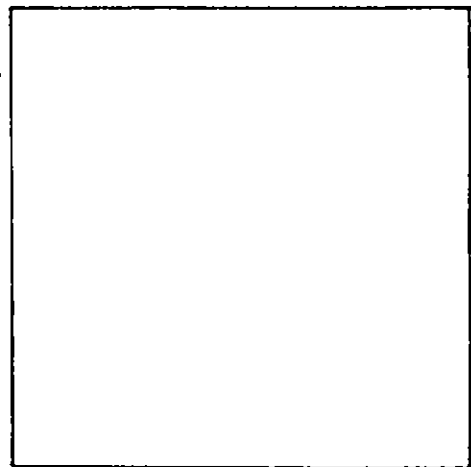

VICINITY: Approx. 1.3 mi. North along I-5 from
Cox Rd. overcrossing, approx. mi. post 157.9.

NOTE: For Possible Further Information On This Station, Please Contact The Douglas County Surveyors Office, Rm. 205 Douglas County Justice Bldg., Roseburg, OR. 97470 Phone 672-3311 Ext. 272.. Douglas County residents outside the Roseburg calling area dial toll free 1-800-452-0991.