

OFFICE OF THE
DOUGLAS COUNTY SURVEYOR

Station: NU 4 T 26 S, R 6, Sec 27

Set By (Agency): DCSO

Date Set: 1972

Recovered By RWS, SJF


Date Recovered Sept. 25, 1986

Recovered By _____

Date Recovered _____

Recovered By _____

Date Recovered _____

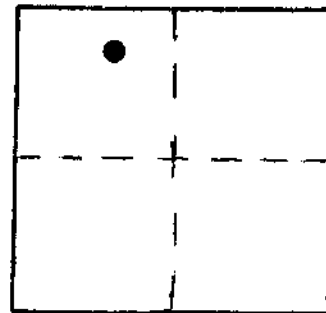

n-032
NU 4

26S 6W 27

NAD 602631.17 4149497.20
83 43°17' 1" 123°23'57"

VERTICAL CONTROL NGVD 29

Elevation: 477.809 NGS Line # _____ USGS Line # _____ OSHD Line # _____

Precision: 2nd Agency: DCSO Proj. # 2007 Date: 1990

HORIZONTAL CONTROL OCS 27

South Zone State Plane Coordinates: Y(Northing) 602,666.21 X(Easting) 1,228,538.43

Precision: 1/25,000 Agency: DCSO Proj. # 2006 Date: 1974

Approximate Geographic Position: Latitude 43°17'01" Longitude 123°23'52"


DESCRIPTION and TO REACH

SKETCH

A DCSO disk stamped "NU 4 1972" set in an 8 inch diameter concrete filled belltile protruding 7 inches above ground.

TO REACH:

Go to the intersection of Del Rio Road (Co. Rd. #115) and Country Hill Drive (Co. Rd. #310) in T26S, R6W, Sec. 27. Monument is 87 feet east of intersection and on north side of Del Rio Road.

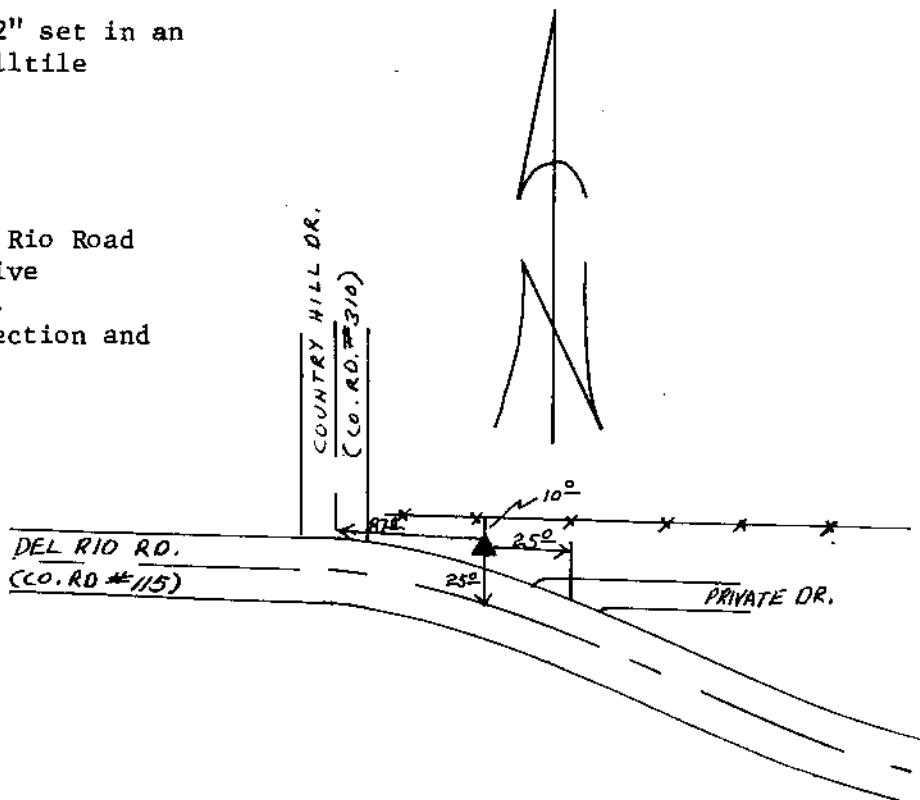

Reference Marks:

Note: For further information, contact the Douglas County Surveyor's Office, Room 205 Douglas County Justice Building, Roseburg, OR 97470. Phone 440-4278. Douglas County residents outside the Roseburg calling area, dial toll free 1-800-452-0991.