

OFFICE OF THE

DOUGLAS COUNTY SURVEYOR

11/19/81

n-046
NU-18

265 4W 18

NAD 609110.93 4197488.97
83 43°18'21" 123°13'11"


T 26 S, R 4 W, Sec. 18

Station: NU-18

Set By (Agency): DCSO

Date: 1972

FD OK 5/99 DCSO

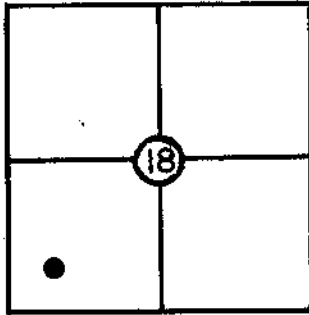

VERTICAL CONTROL

NGVD 29

Elevation: 726.465 NGS(USC&GS) Line # _____ USGS Line # _____

Order (River Floodplain)
Of Precision 2nd Agency: DCSO Proj. #: 2006 Date: 1972

CS 66/37

HORIZONTAL CONTROL


OCS 27

Oregon State Plane Coordinates: Y(Northing) 609,146.19 X(Easting) 1,276,529.67
(South Zone)

Order (River Floodplain)
Of Precision 1/25,000 Agency: DCSO Proj. #: 2006 Date: 1972

Approximate Geographic Position: Latitude= 43°18'21" Longitude= 123°13'07"

DESCRIPTION: Bronze disk set in conc. mon.
with survey marker alongside. Set flush
with ground. Disk stamped "NU-18 1972",
65' South of Road centerline and 6 ft.
higher.

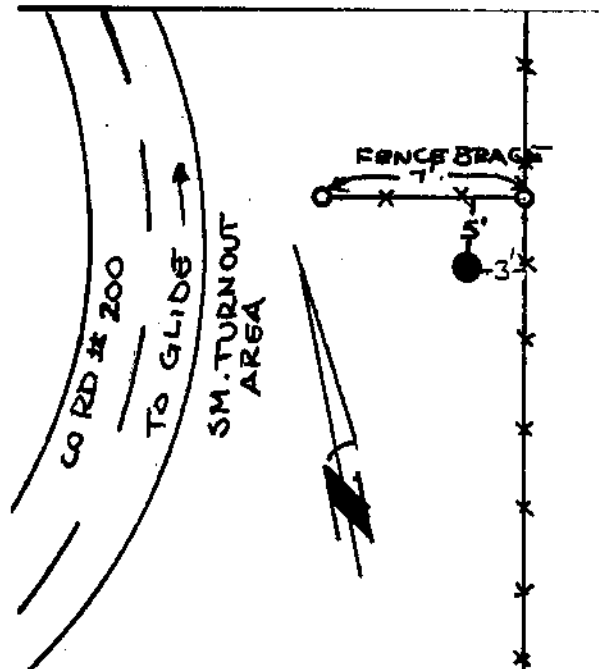

VICINITY: Approx. 9.4 mi Easterly of inter-
section of Wilbur-Glide cutoff and Hwy 99
along Wilbur-Glide Cutoff Rd.

NOTE: For Possible Further Information On This Station, Please Contact The Douglas
County Surveyors Office, Rm. 205 Douglas County Justice Bldg., Roseburg, OR.
97470 Phone 672-3311 Ext. 272. Douglas County residents outside the
Roseburg calling area dial toll free 1-800-452-0991.