

12/22/81


OFFICE OF THE

n-047
NU-19

26S 4W 18

DOUGLAS COUNTY SURVEYOR

NAD 611163.16 4198958.31
83 43°18'41" 123°12'52"

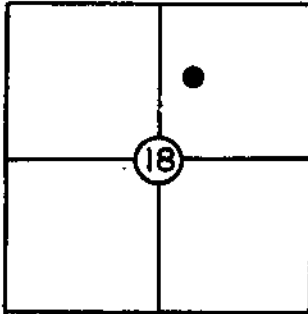

T 26 S, R 4W, Sec. 18

Station: NU 19

Set By (Agency): DCSO

Date: 1972

FD OK PER BENTZ 9/93 1995-0090
FD OK DCSO 5/99

VERTICAL CONTROL

N6VD 29

Elevation: 731.17 NGS(USC&GS) Line # _____ USGS Line # _____

Order Of Precision 3rd Agency: DCSO Proj. #: 2007 Date: 1999
CS 66/37

HORIZONTAL CONTROL


OCS 27

Oregon State Plane Coordinates: Y(Northing) 611,198.43 X(Easting) 1,277,998.96
(South Zone)

Order (River Floodplain)
Of Precision 1/25,000 Agency: DCSO Proj. #: 2006 Date: 1972

Approximate Geographic Position: Latitude= 43°18'42" Longitude= 123°12'48"

DESCRIPTION: Bronze disk set in concrete
post, survey marker alongside, disk stamped
"NU 19 1972" & is 3 ft. higher than Park
Rd. (Whistlers Bend Co. Park.) The Disk
also lies in the saddle before dropping to
main park.
N'thly along road, approx. 950 ft. from
gate to park.

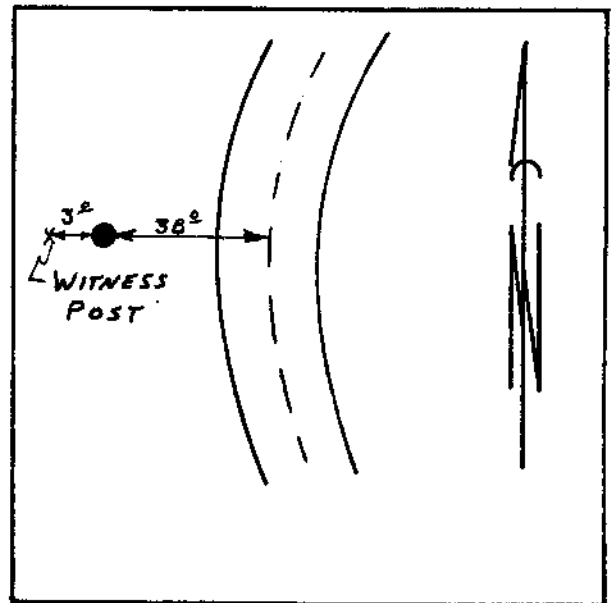

VICINITY: 2.9 mi. W'stly on Whistlers
Bend Rd.

NOTE: For Possible Further Information On This Station, Please Contact The Douglas County Surveyors Office, Rm. 205 Douglas County Justice Bldg., Roseburg, OR. 97470 Phone 672-3311 Ext. 272. Douglas County residents outside the Roseburg calling area dial toll free 1-800-452-0991.