


OFFICE OF THE
DOUGLAS COUNTY SURVEYOR

Station: NO 13
 Set By (Agency): USC&GS
 Date Set: 1974
 Recovered By JRL, SJF
 Date Recovered 8/11/86
 Recovered By _____
 Date Recovered _____
 Recovered By _____
 Date Recovered _____

T 22S S, R 13W , Sec 12

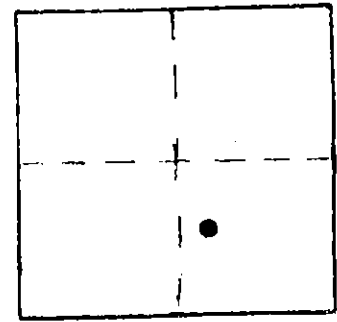

NAD 752455.26 3544831.48
 83 43°40'20" 124°11'31"

VERTICAL CONTROL

Elevation: 17.35 ft. Tidal Info. NGS Line # _____ USGS Line # _____ OSHD Line # _____
 Precision: 3rd. Agency: NGS Proj. # _____ Date: 1986

HORIZONTAL CONTROL


South Zone State Plane Coordinates: Y(Northing) 752,500.24 X(Easting) 1,023,870.81
 Precision: 1/25,000 Agency: DCSO Proj. # 6004-5 Date: 12/04/86
 Approximate Geographic Position: Latitude 43°40'21" Longitude 124°11'26"

DESCRIPTION and TO REACH

A USC&GS disk stamped "NO 13 + 1974" set flush in a 9x9x9 foot sandstone boulder in the parking-lot for Windy Cove Pier (old Coast Gaurd boathouse pier). Disk is on line with pier.

From the bridge on 9th. Blvd. crossing Winchester Creek in T22S,R12W,Sec. 7 proceed southwesterly along 9th. Blvd. approx. 0.8 miles to monument on right.

SKETCH

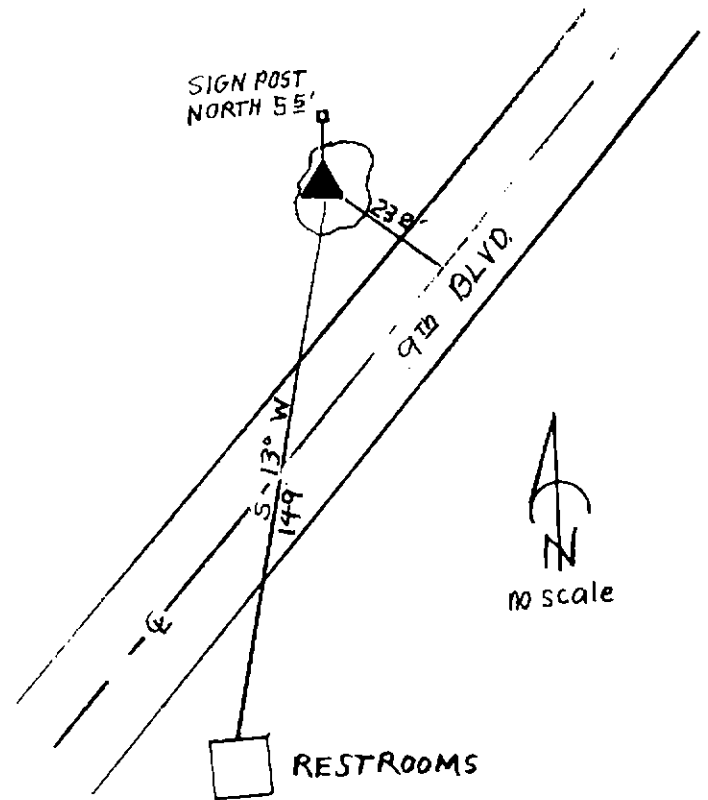

Reference Marks:

Note: For further information, contact the Douglas County Surveyor's Office, Room 205 Douglas County Justice Building, Roseburg, OR 97470. Phone 440-4278. Douglas County residents outside the Roseburg calling area, dial toll free 1-800-452-0991.