


OFFICE OF THE
DOUGLAS COUNTY SURVEYOR

N-059

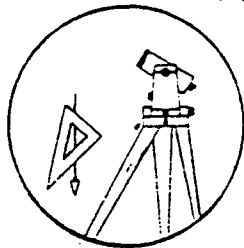

Station: NANDY

T 27 S, R 7 W, Sec 25

Date Set: 1989

Set By (Agency): DCSO

Date Recovered: 6/29/89


Recovered By: RWS,SJF

Date Recovered: _____

Recovered By: _____

Date Recovered: _____

Recovered By: _____

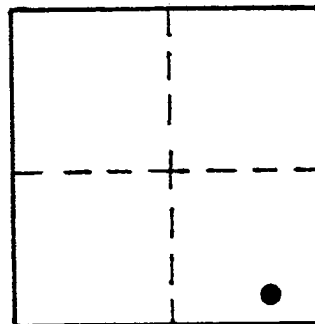

VERTICAL CONTROL

Elevation: 622.703 NGS Line # _____ USGS Line # _____ OSHD Line # _____

Precision: 2nd Agency: DCSO Proj. # 2007 Date: 1990

HORIZONTAL CONTROL CORPSCON 6 NAV 88 626.18 FT

South Zone O.C.S. 27: Y(Northing) _____ X(Easting) _____

South Zone O.C.S. 83: Y(Northing) 567825 X(Easting) 4129194

Precision: GIS SCALED Agency: DCSO Proj. # _____ Date: 2014


Approx. NAD 83 Geographic Position: Latitude _____ Longitude _____

DESCRIPTION and TO REACH

SKETCH

A DCSO drill cap stamped "NANDY 1990" set in northwest corner of bridge over small creek.

Go to the intersection of Nandy Dr. (Co.Rd.#336) and Lookingglass Rd. (Co.Rd.#5D) in T27S,R7W, Sec.25, proceed northeasterly along Lookingglass Rd. approx. 0.08 miles to bridge and monument in northwest corner.

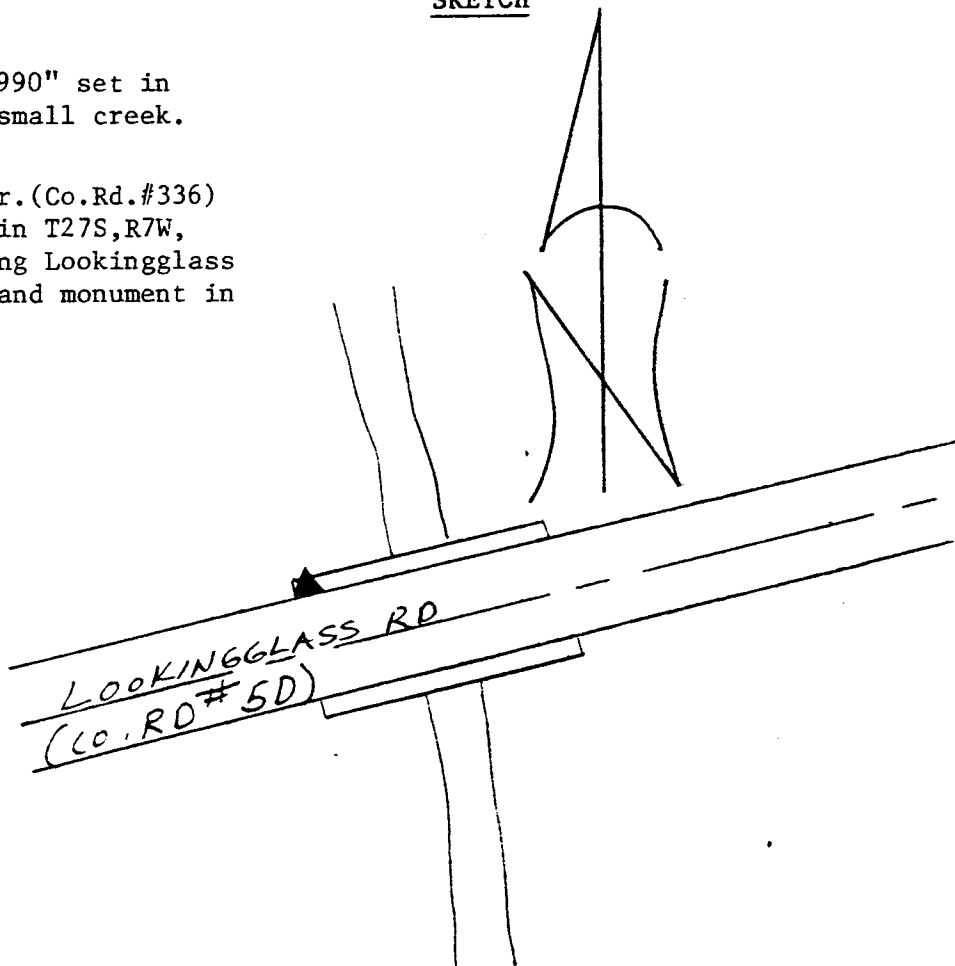

Reference Marks:

Note: For further information, contact the Douglas County Surveyor's Office, Room 205 Douglas County Justice Building, Roseburg, OR 97470. Phone 440-4278. Douglas County residents outside the Roseburg calling area, dial toll free 1-800-452-0991.